



TOTAL SF AVAILABLE -31,385 RSF(9%)

[Click to access 3D model](#)

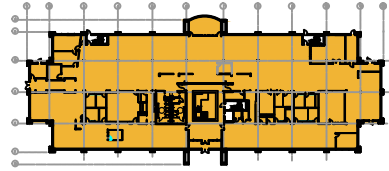

Key Plan

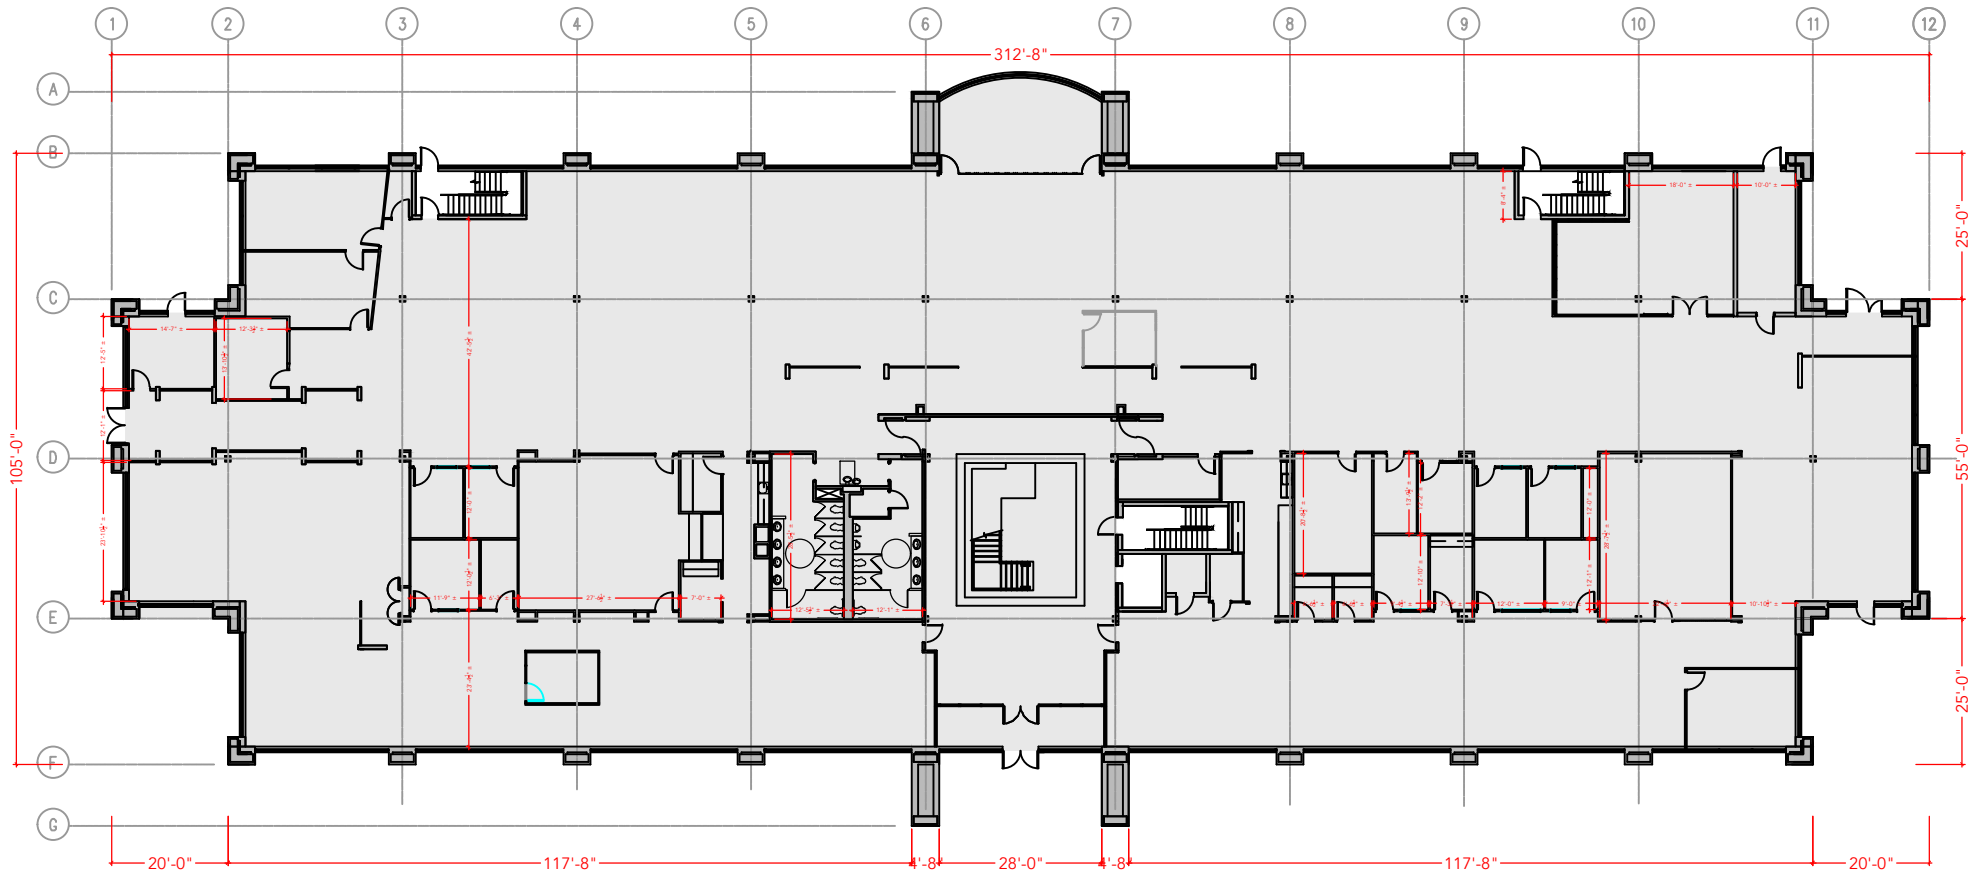

Floor Plan