


**TOTAL SF AVAILABLE -4,200 SF**

**OFFICE - 2,081 SF**

**WAREHOUSE - 2,119 SF**

[Click to access 3D model](#)

## Key Plan

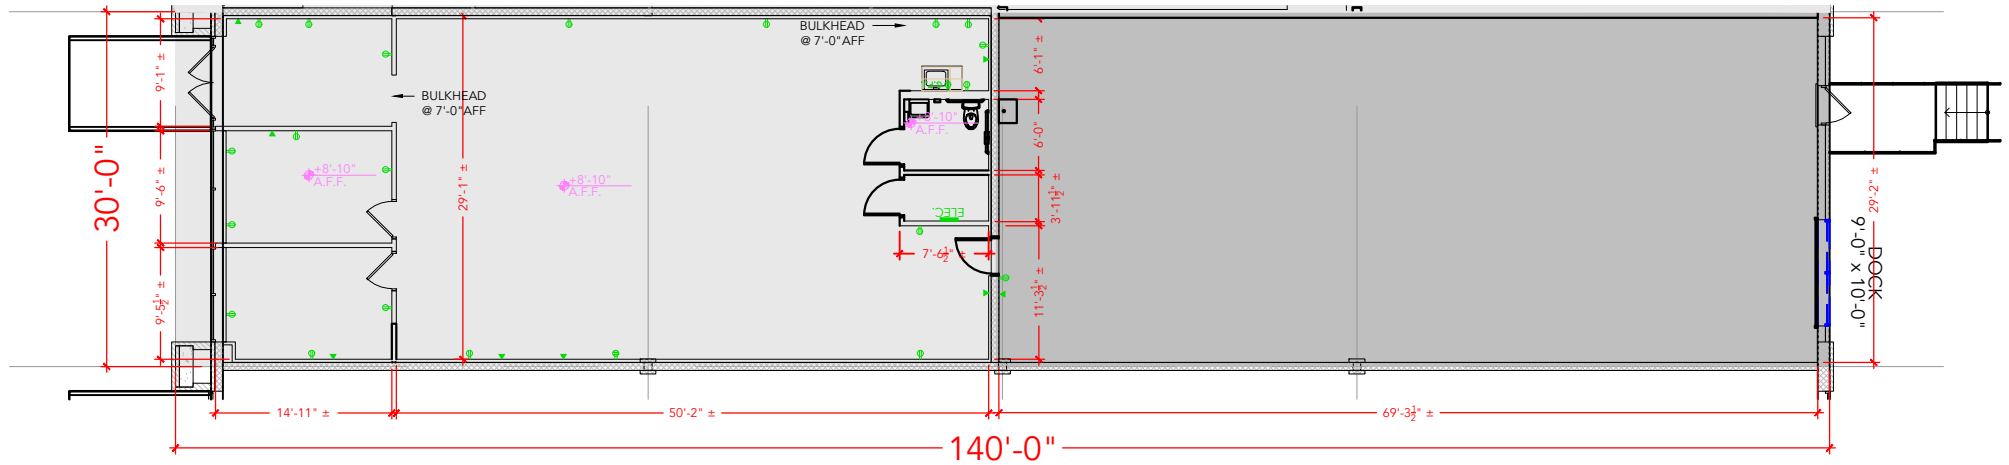

## Floor Plan