


TOTAL SF AVAILABLE - 5,400 SF

OFFICE - 0,000 SF

WAREHOUSE SF - 5,400 SF


[Click to access 3D model](#)

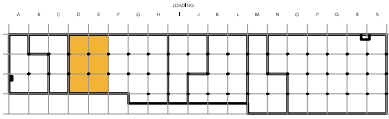

Key Plan

E

D

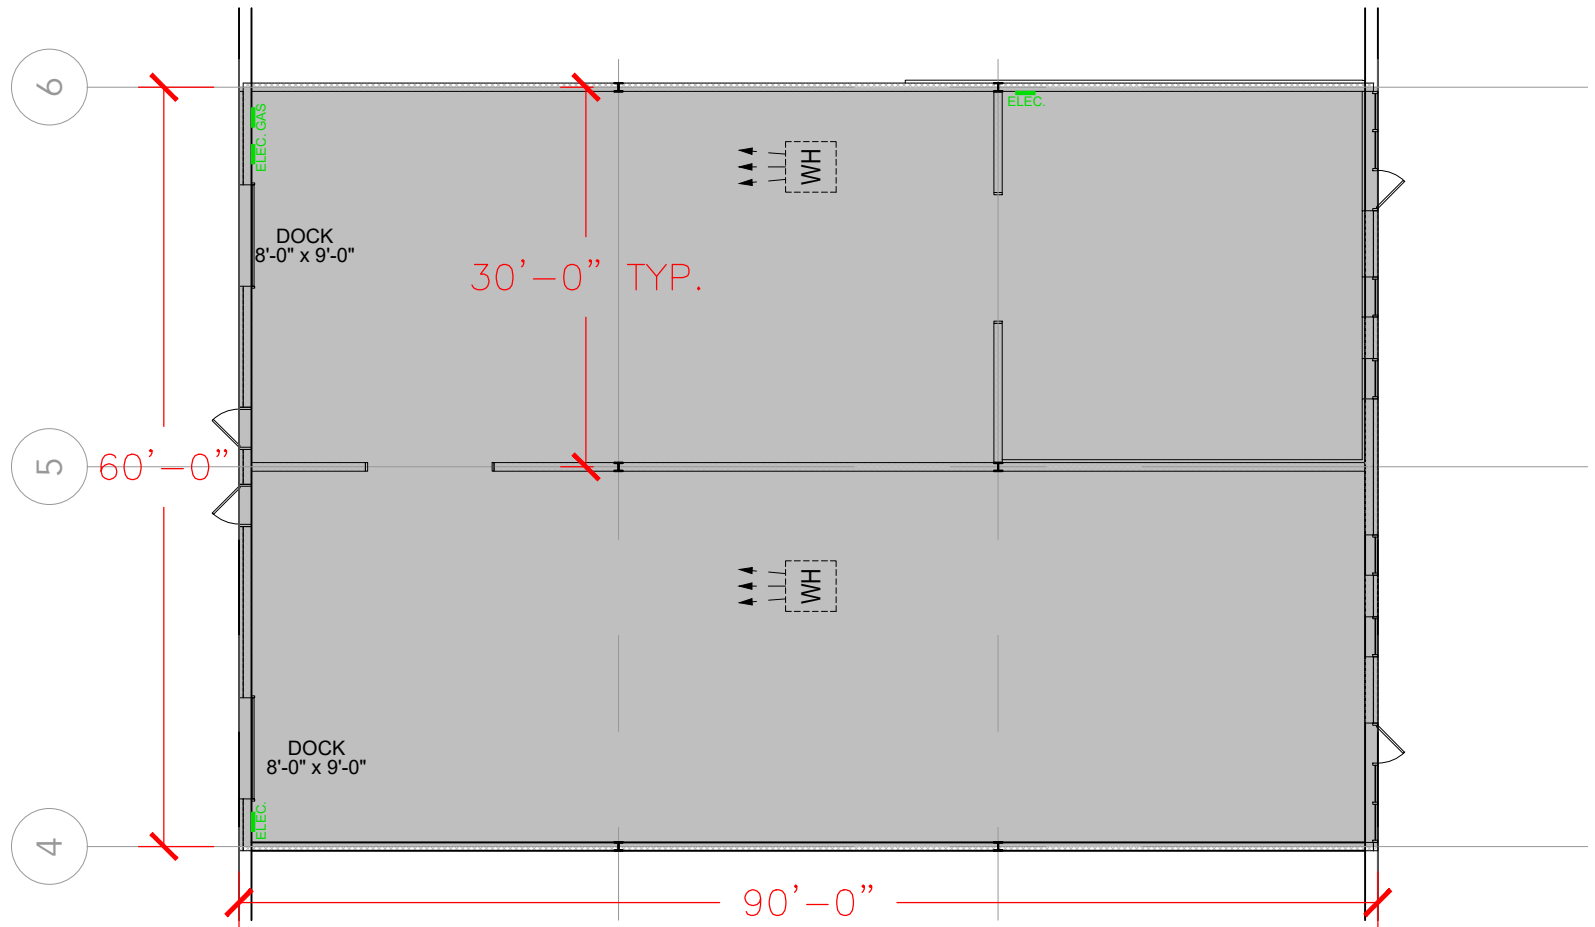

Floor Plan