



TOTAL SF AVAILABLE - 4,950 SF

OFFICE - 985 SF
WAREHOUSE SF - 3,965 SF

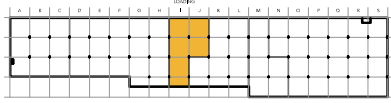

Key Plan

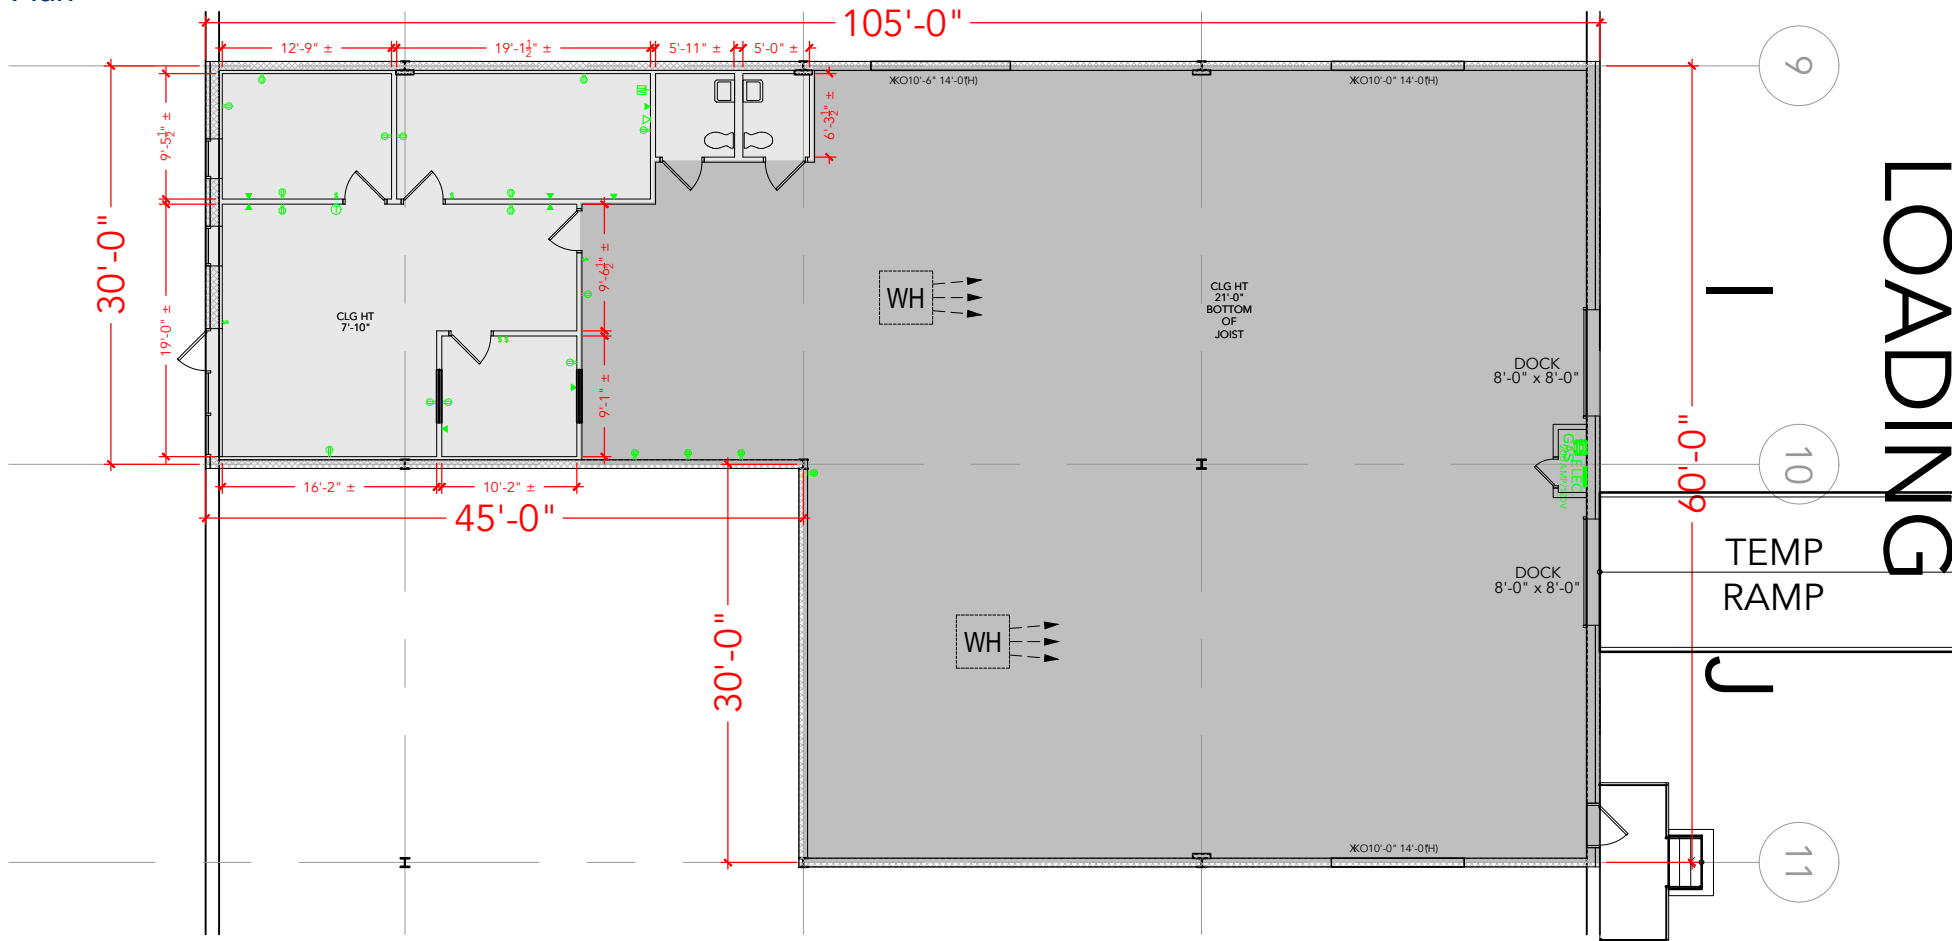

Floor Plan