

MEADOWRIDGE 95 - BUILDING 2

6518 MEADOWRIDGE RD ELKRIDGE, MD 21075 SUITE 200-210 & 236-242


TOTAL SF AVAILABLE -17,228 RSF(16%)

UNCLASSIFIED - 12,898 RSF(16%) CLASSIFIED - 4,330 RSF(16%)

Click to access CADD file



Key Plan

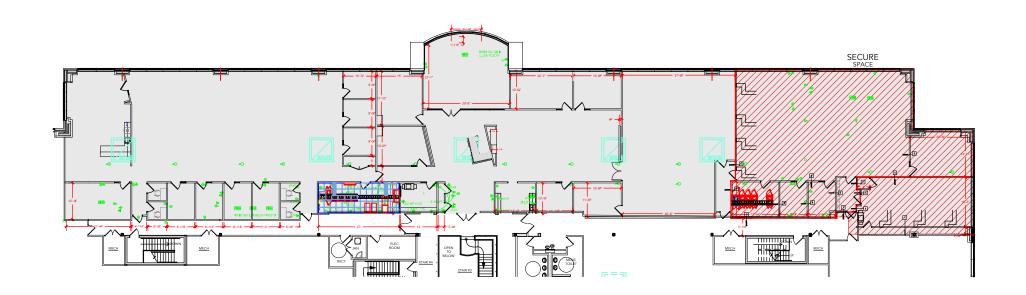

Floor Plan