


TOTAL SF AVAILABLE -61,145 SF


OFFICE - 4,325 SF

WAREHOUSE - 56,820 SF

[Click to access 3D model](#)

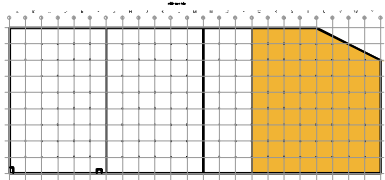

Key Plan

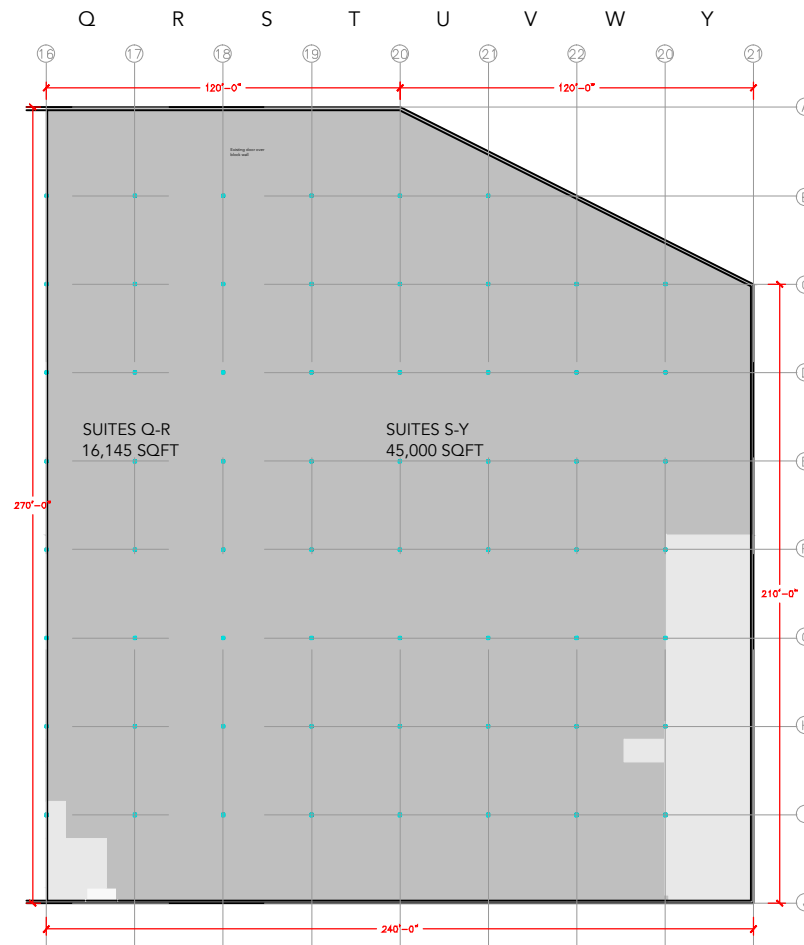

Floor Plan