


**TOTAL SF AVAILABLE -8,303 SF**


OFFICE - 925 SF

WAREHOUSE - 7,378 SF

[Click to access 3D model](#)

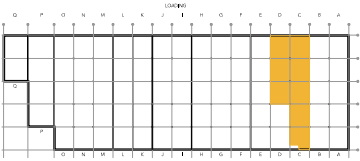

Key Plan

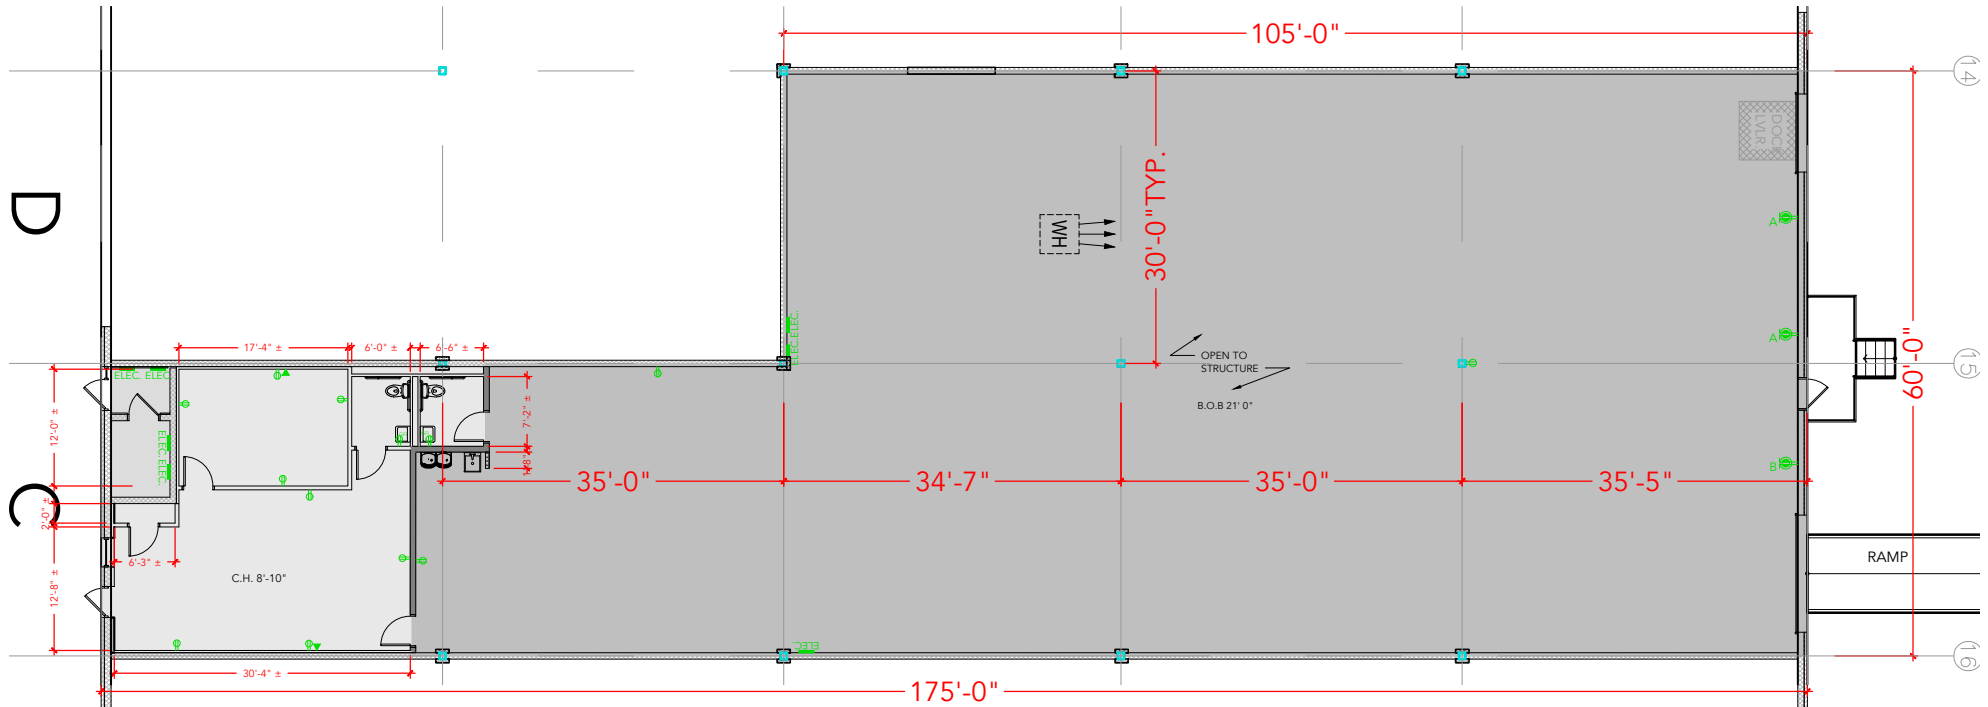

Floor Plan