


TOTAL SF AVAILABLE -15,675 SF



OFFICE - 1,549 SF

WAREHOUSE - 14,125 SF

* 1,337 SF MEZZ. NOT INCLUDED IN TOTAL SF
[Click to access 3D model](#)

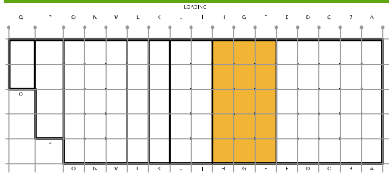

Key Plan

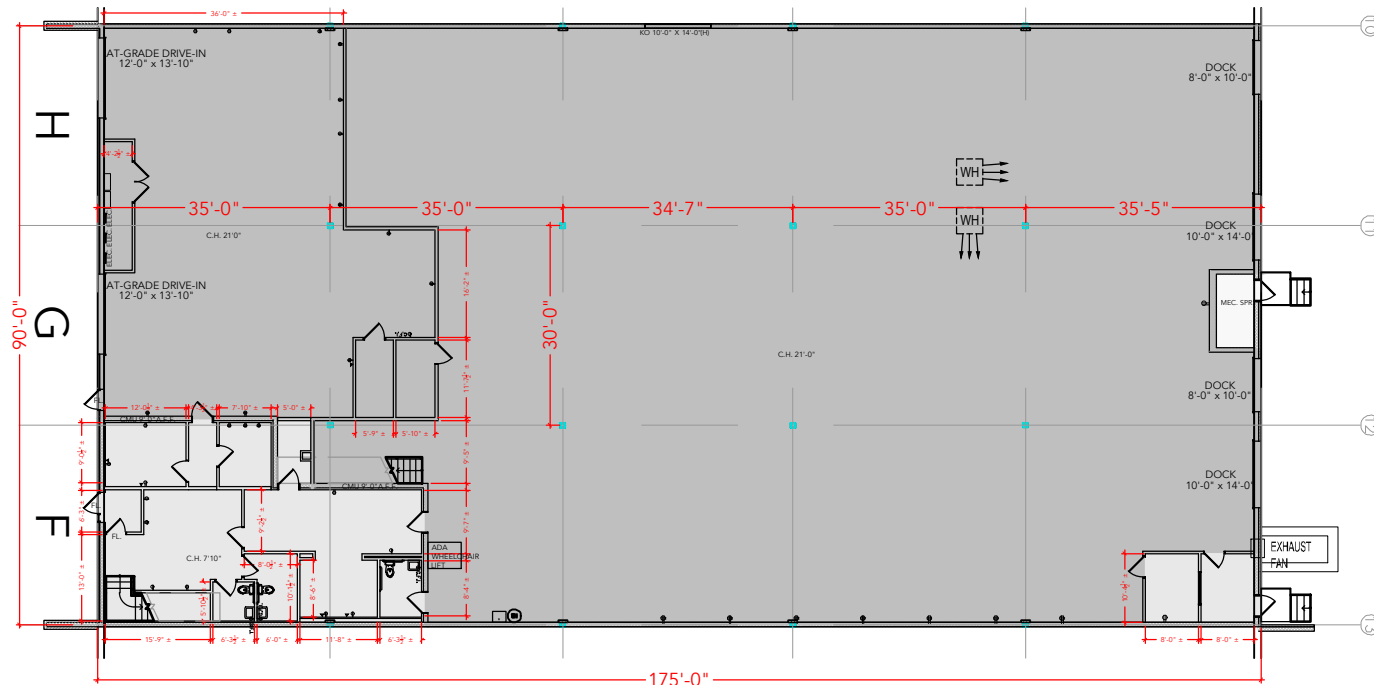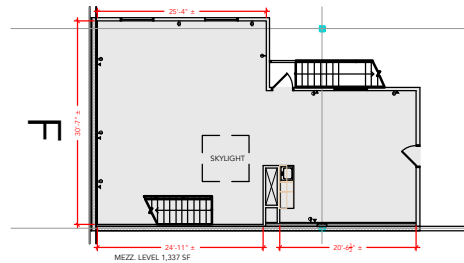

Floor Plan