


TOTAL SF AVAILABLE -5,250 SF


OFFICE - 0,000 SF

WAREHOUSE SF - 5,250 SF

[Click to access 3D model](#)

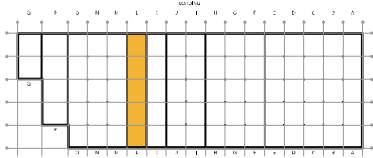

Key Plan

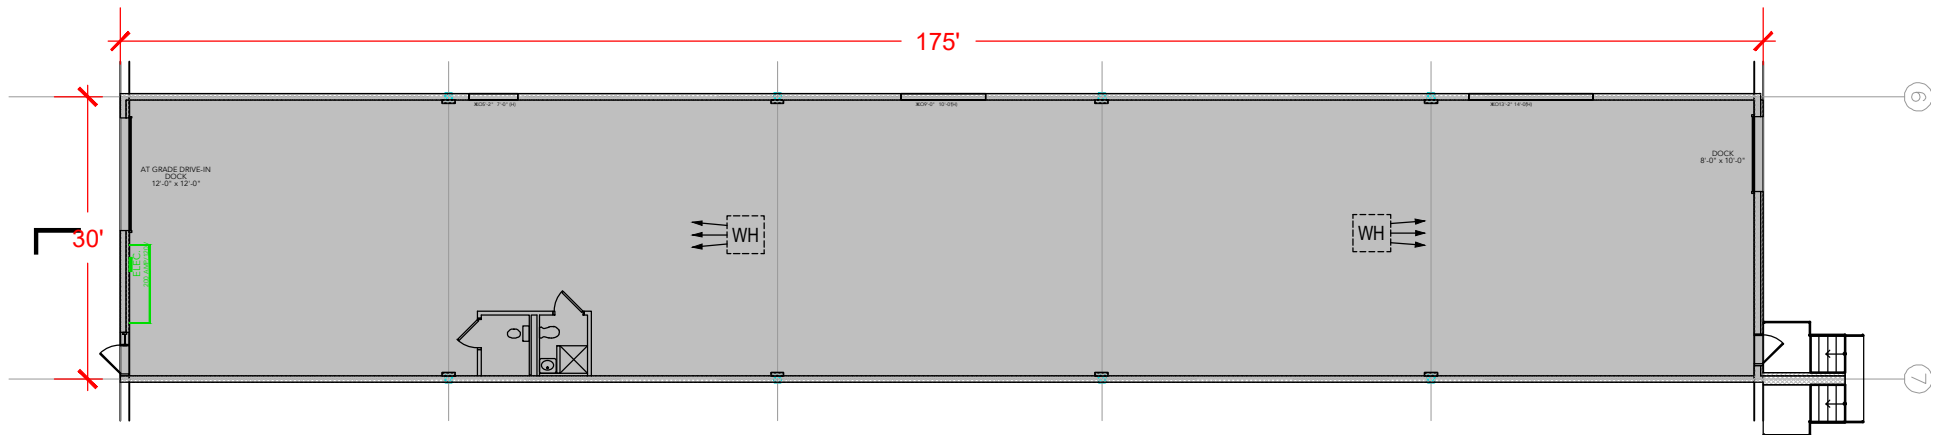

Floor Plan