


**TOTAL SF AVAILABLE -5,250 SF**


**OFFICE - 1,938 SF**

**WAREHOUSE - 3,312 SF**

[Click to access 3D model](#)

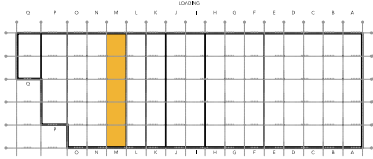

Key Plan

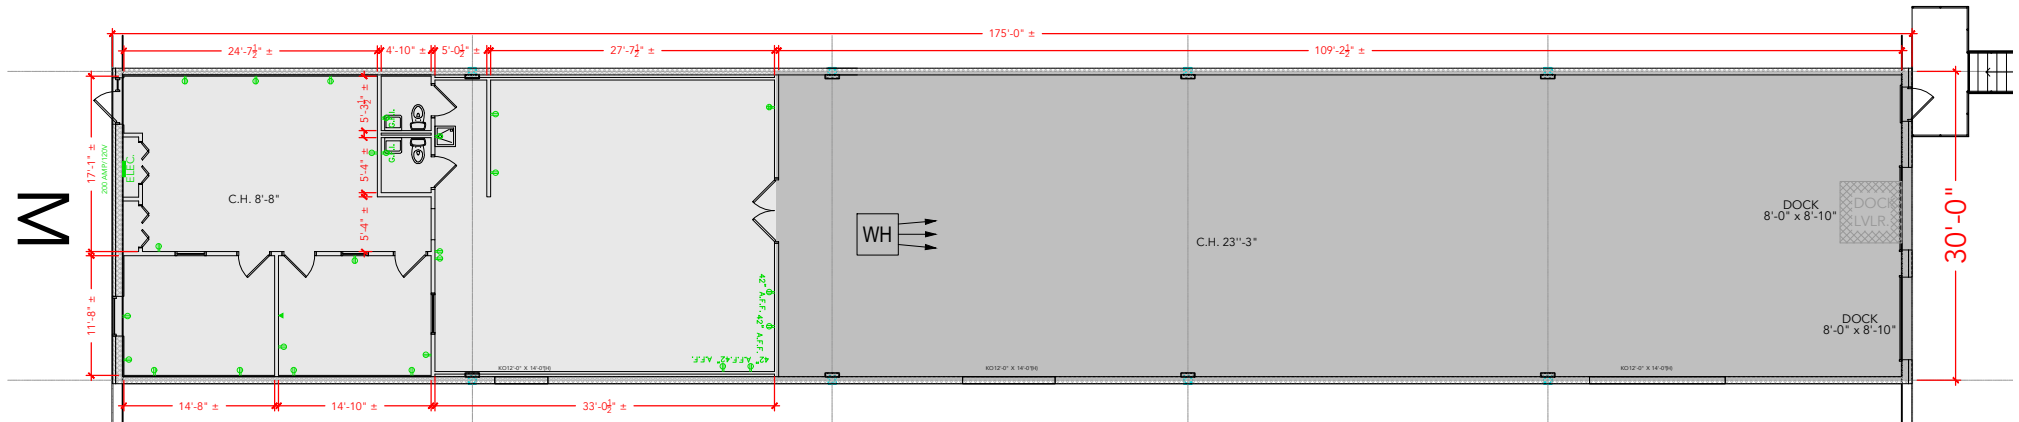

Floor Plan