



TOTAL SF AVAILABLE -1,764 RSF

OFFICE - 315 RSF
WAREHOUSE - 1,449 RSF

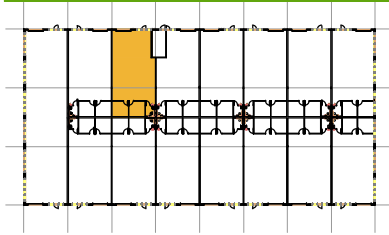

Key Plan

165

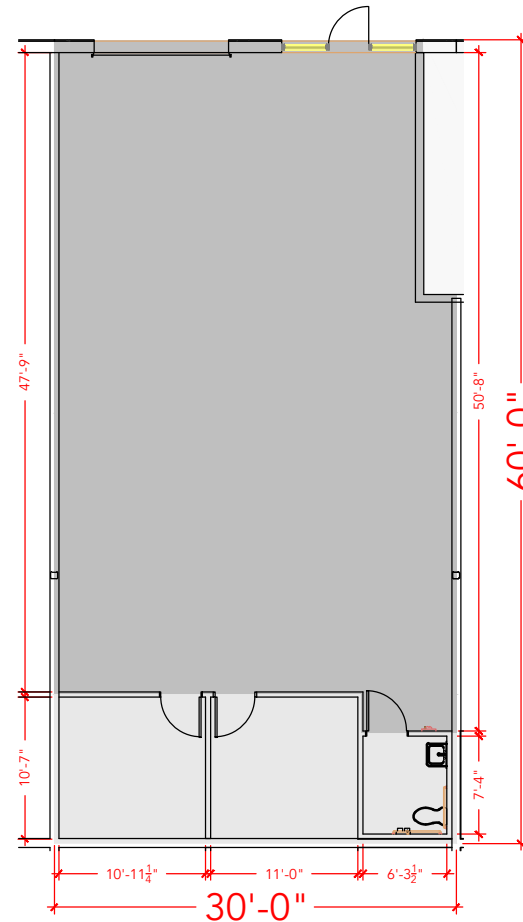

Floor Plan