


TOTAL SF AVAILABLE -1,811 RSF


OFFICE - 315 RSF

WAREHOUSE - 1,496 RSF

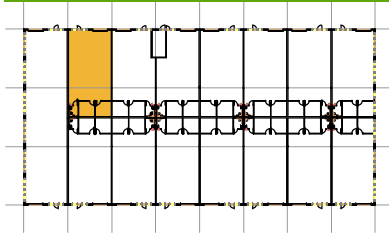

Key Plan

170

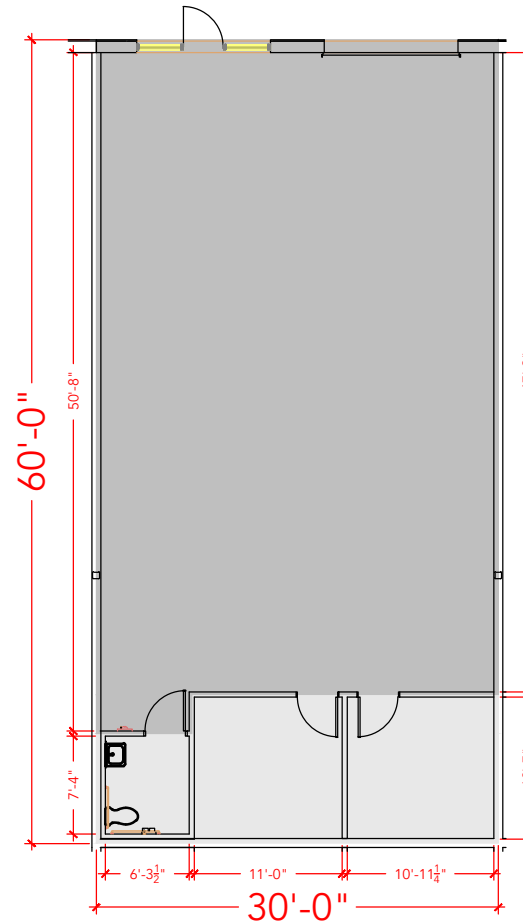

## Floor Plan