

**TOTAL SF AVAILABLE -5,400 SF**


OFFICE - 1,547 SF

WAREHOUSE SF - 3,853 SF

[Click to access 3D model](#)

8800	8802	8804	8806	8808	8810	8812	8814	8816	8818	8820	8822

Key Plan

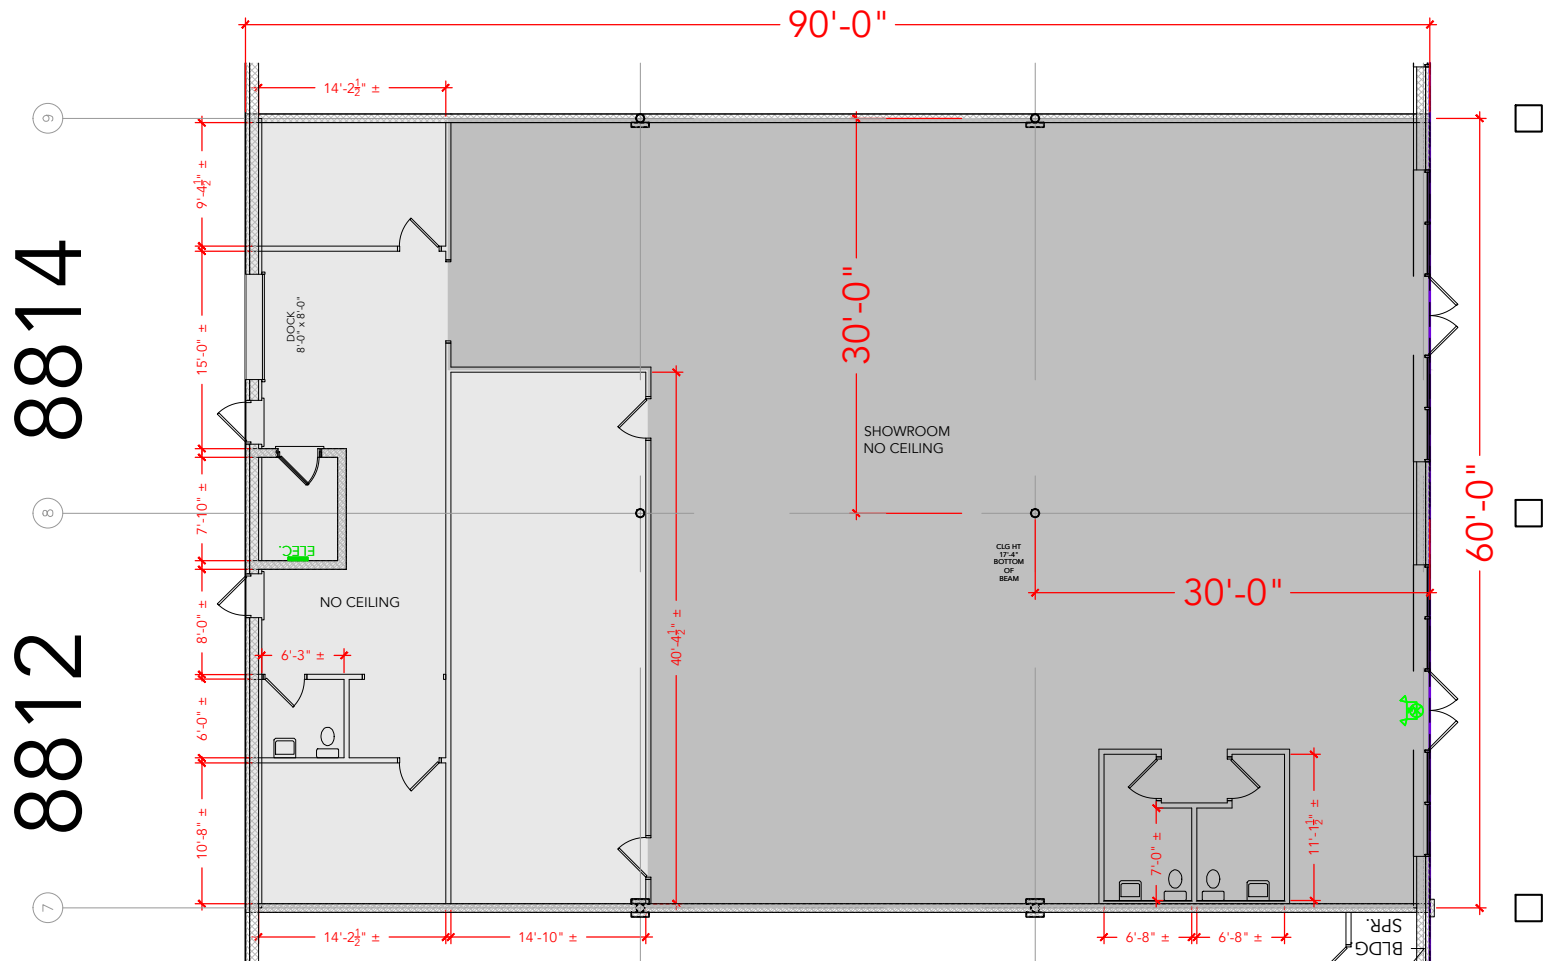

Floor Plan