

**TOTAL SF AVAILABLE -2,250 SF**


OFFICE - 387 SF

WAREHOUSE - 1,863 SF

[Click to access 3D model](#)

8838	8840	8842	8844	8846	8848	8850

Key Plan

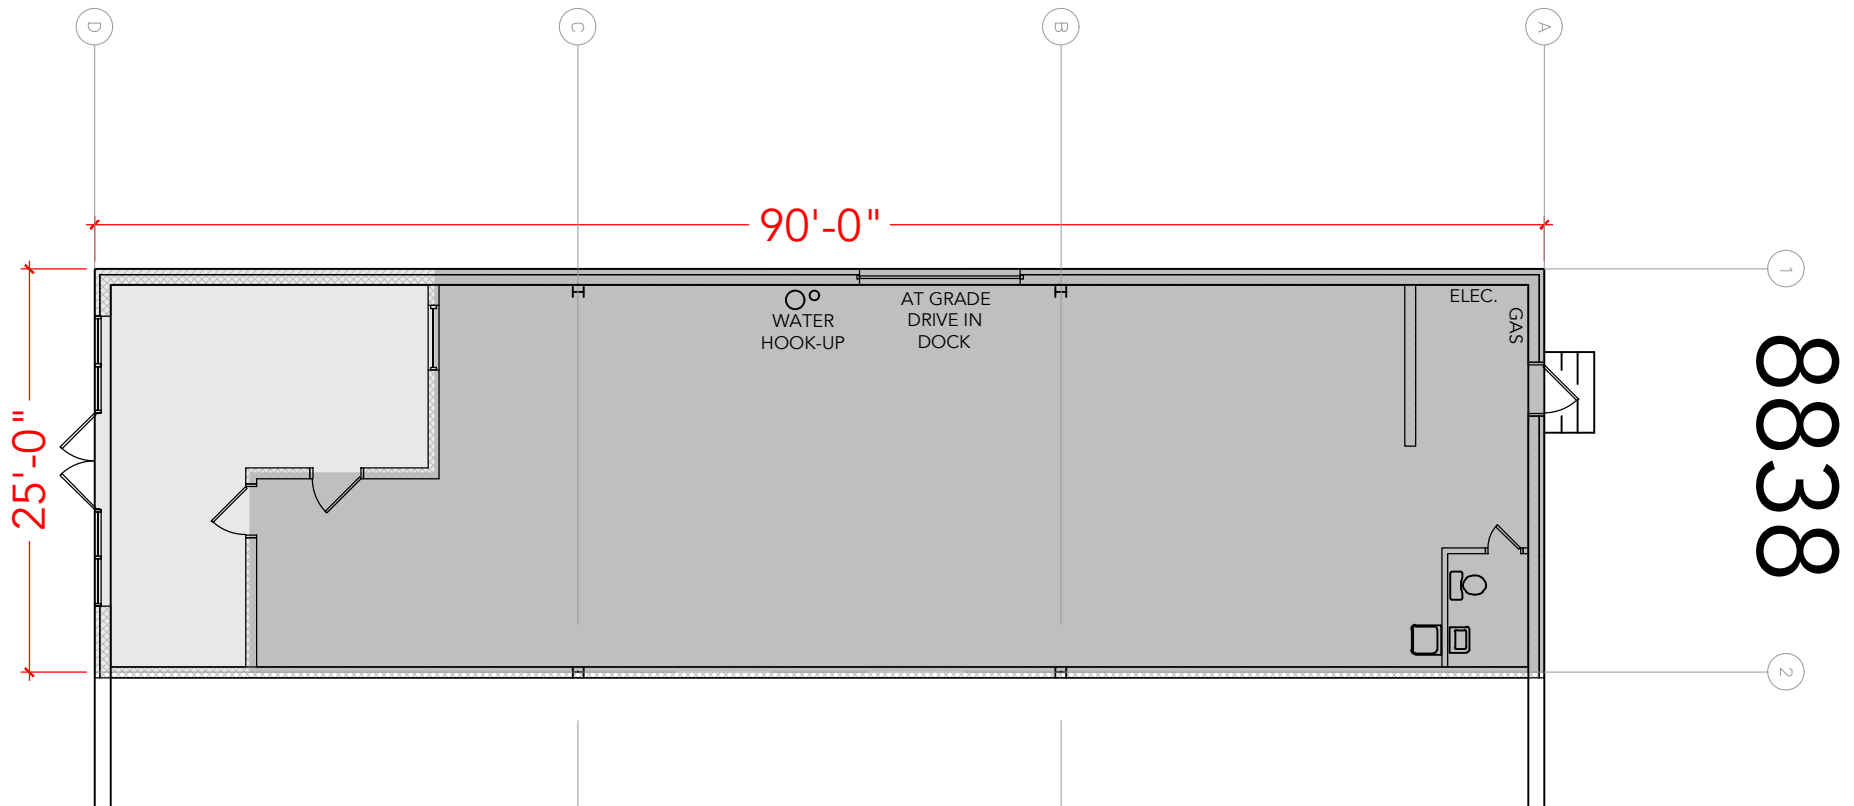

## Floor Plan