


TOTAL SF AVAILABLE -9,120 SF


OFFICE - 3,674 SF

WAREHOUSE SF - 5,446 SF

[Click to access 3D model](#)

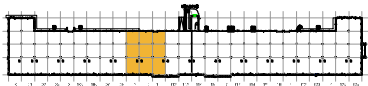

Key Plan

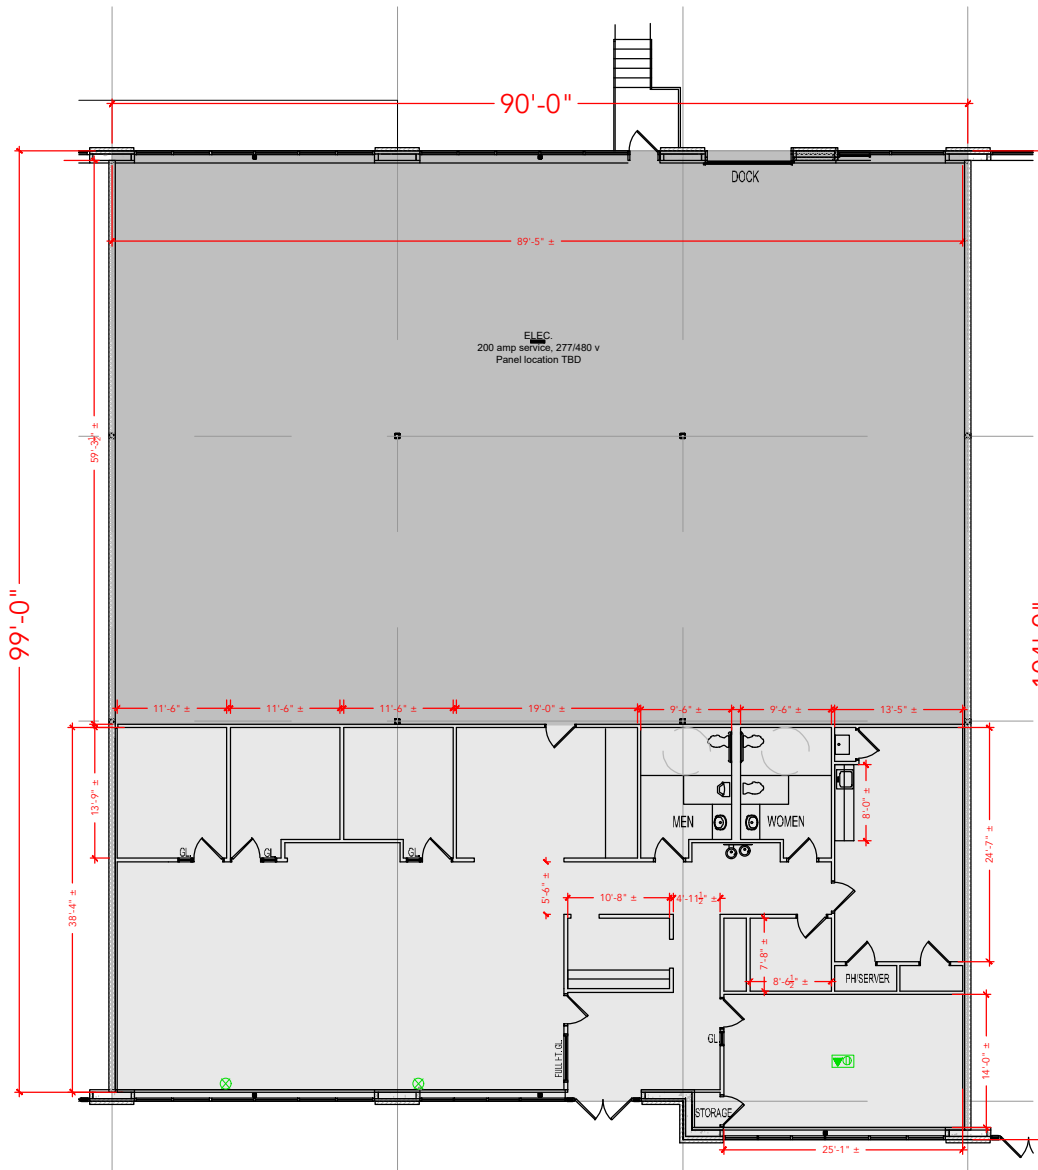

Floor Plan