


TOTAL RSF AVAILABLE -7,237 RSF

OFFICE - 0,000


WAREHOUSE - 7,237 RSF

* INCLUDES % OF METER ROOM

[Click to access 3D model](#)

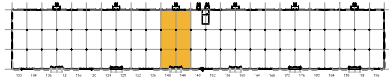

Key Plan

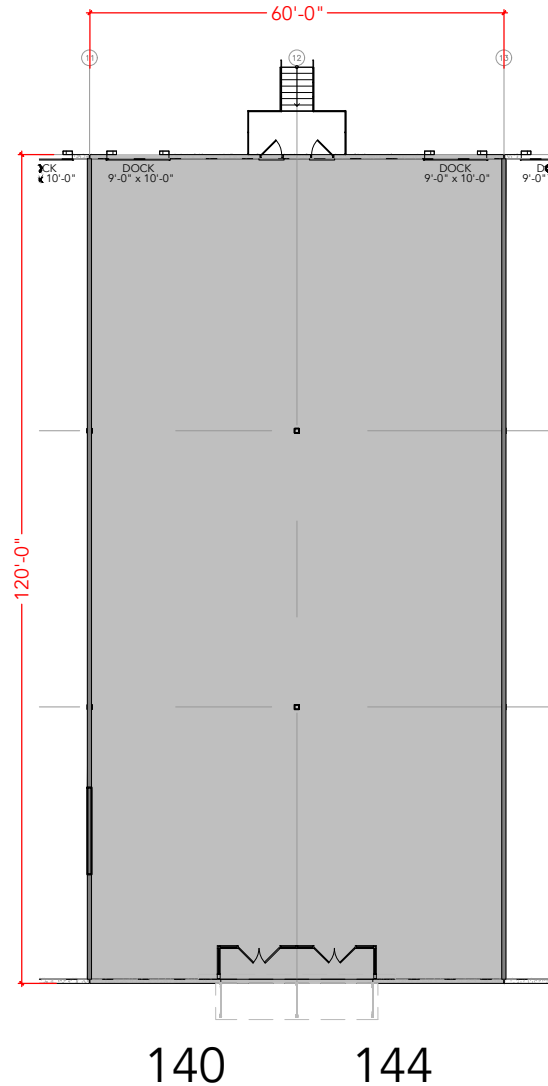

Floor Plan