


TOTAL SF AVAILABLE - 7,036 RSF

OFFICE - 400 SF


WAREHOUSE - 6,636 SF

* INCLUDES % OF METER ROOM

[Click to access 3D model](#)

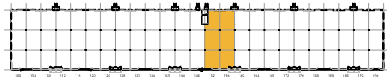

Key Plan

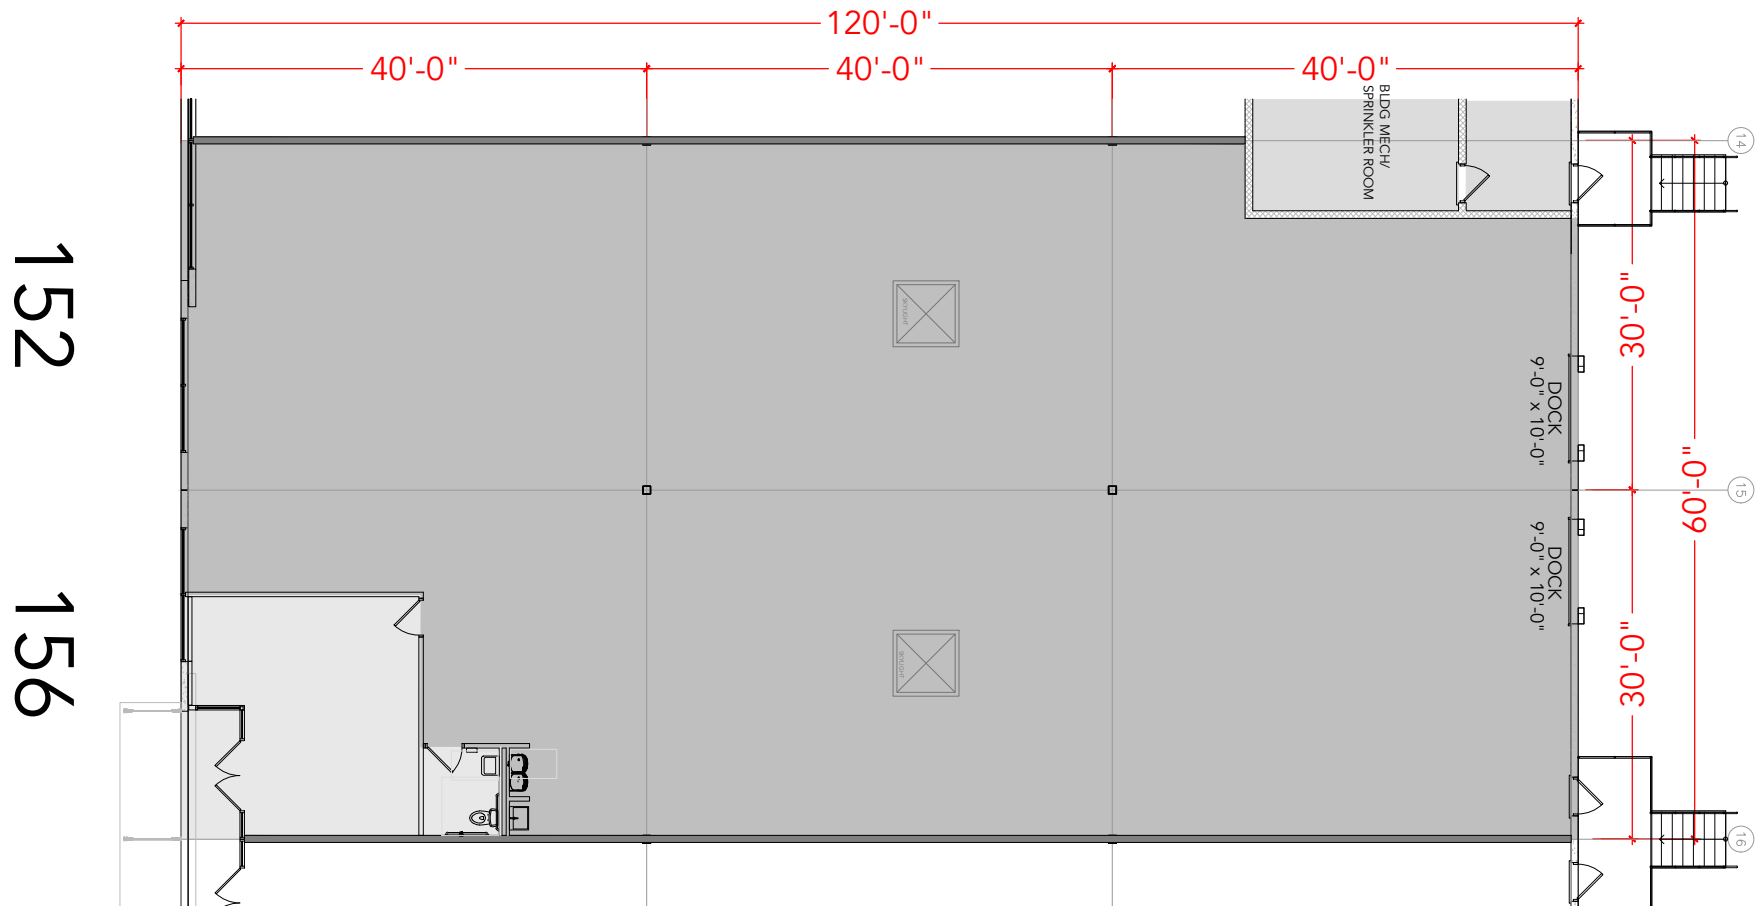

Floor Plan