


**TOTAL SF AVAILABLE -14,122 RSF**

**OFFICE - 0,000 SF**


**WAREHOUSE - 14,122 RSF**

\* INCLUDES % OF METER ROOM

[Click to access 3D model](#)

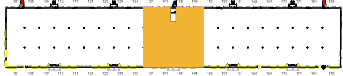

Key Plan

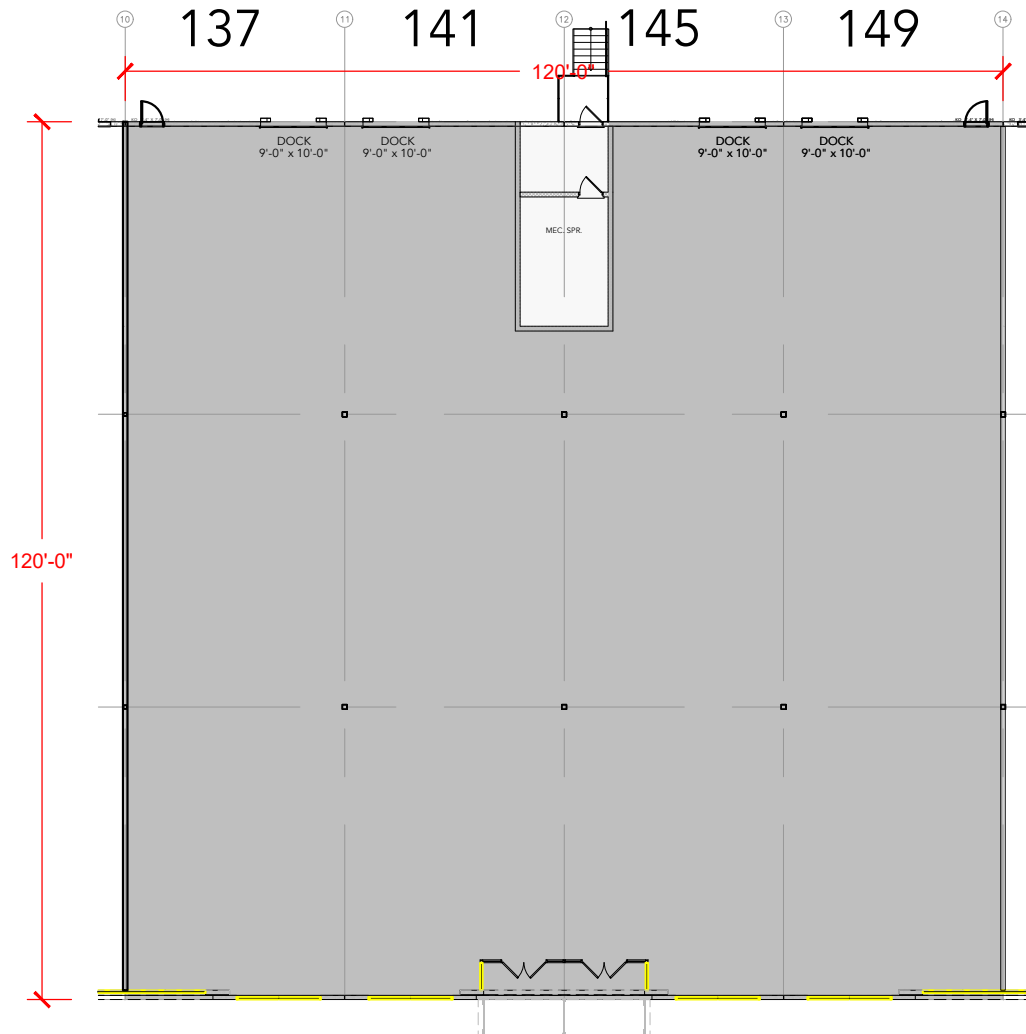

Floor Plan