



TOTAL SF AVAILABLE - 5,402 RSF (16%)

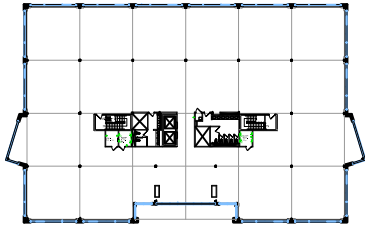

Key Plan

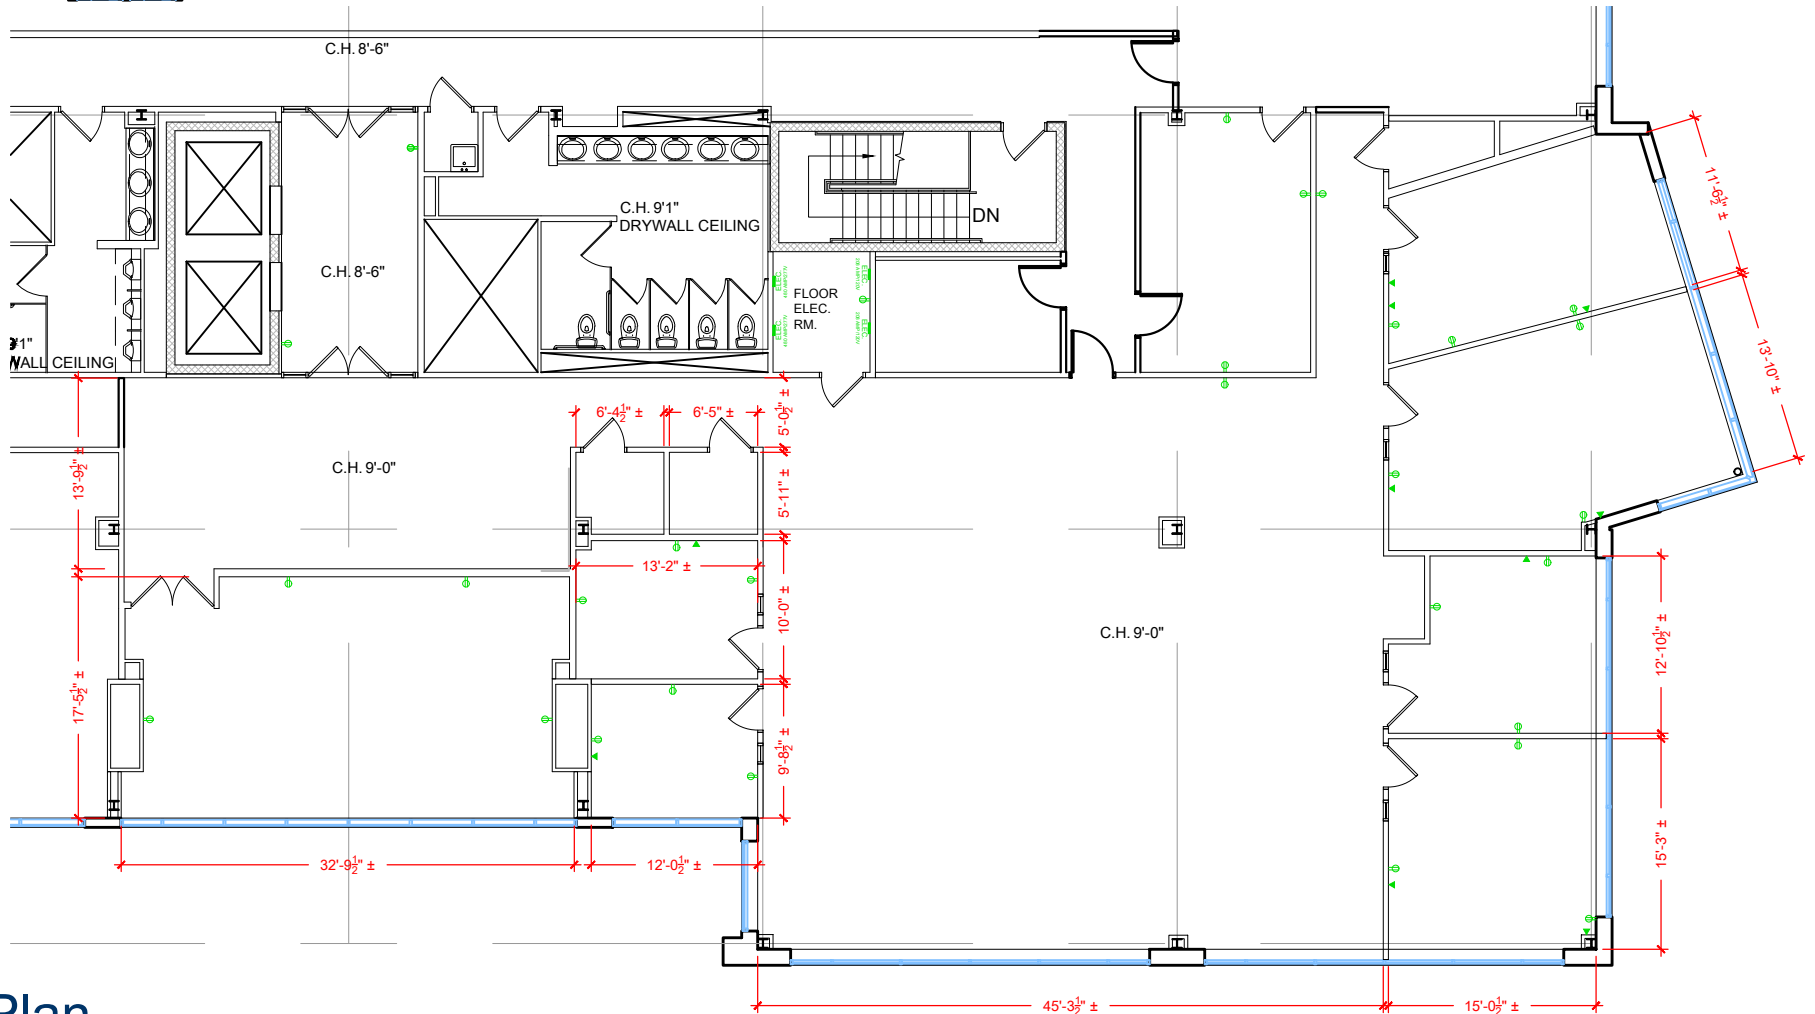

Floor Plan