



TOTAL SF AVAILABLE - 17,058 RSF(16%)

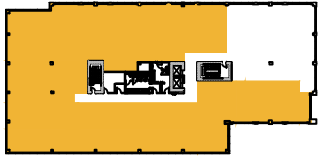

Key Plan

[Click to access 3D model](#)
[Click to view Space Photos](#)

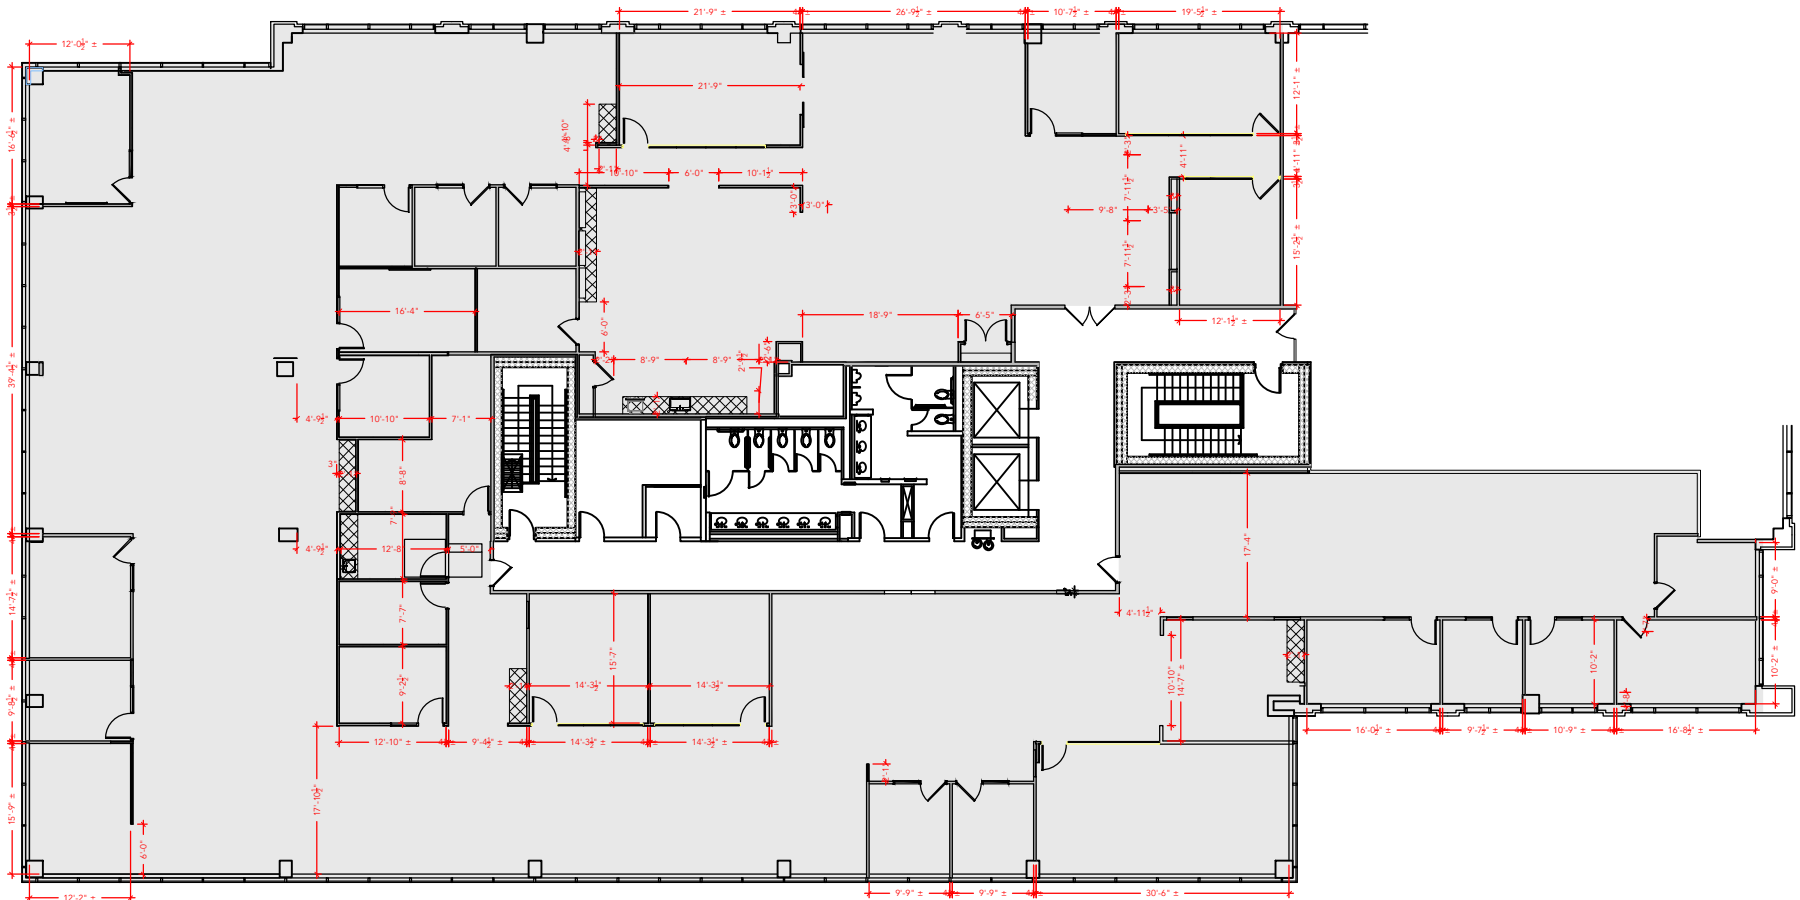

Floor Plan