



TOTAL SF AVAILABLE -744 RSF(12%)

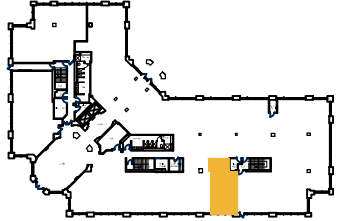

Key Plan

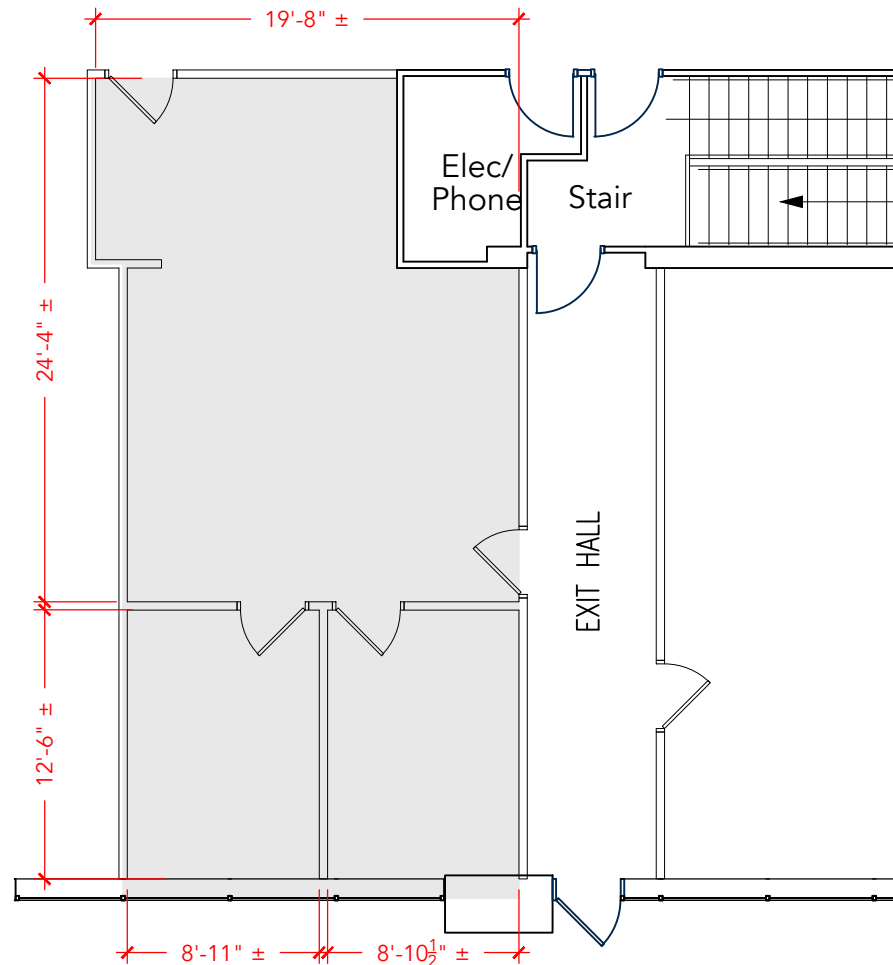

Floor Plan