



TOTAL SF AVAILABLE -2,880 RSF (12%)

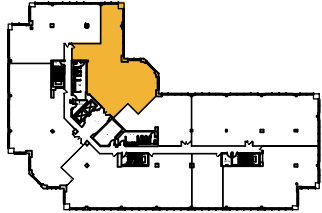

Key Plan

[Click to access 3D model](#)

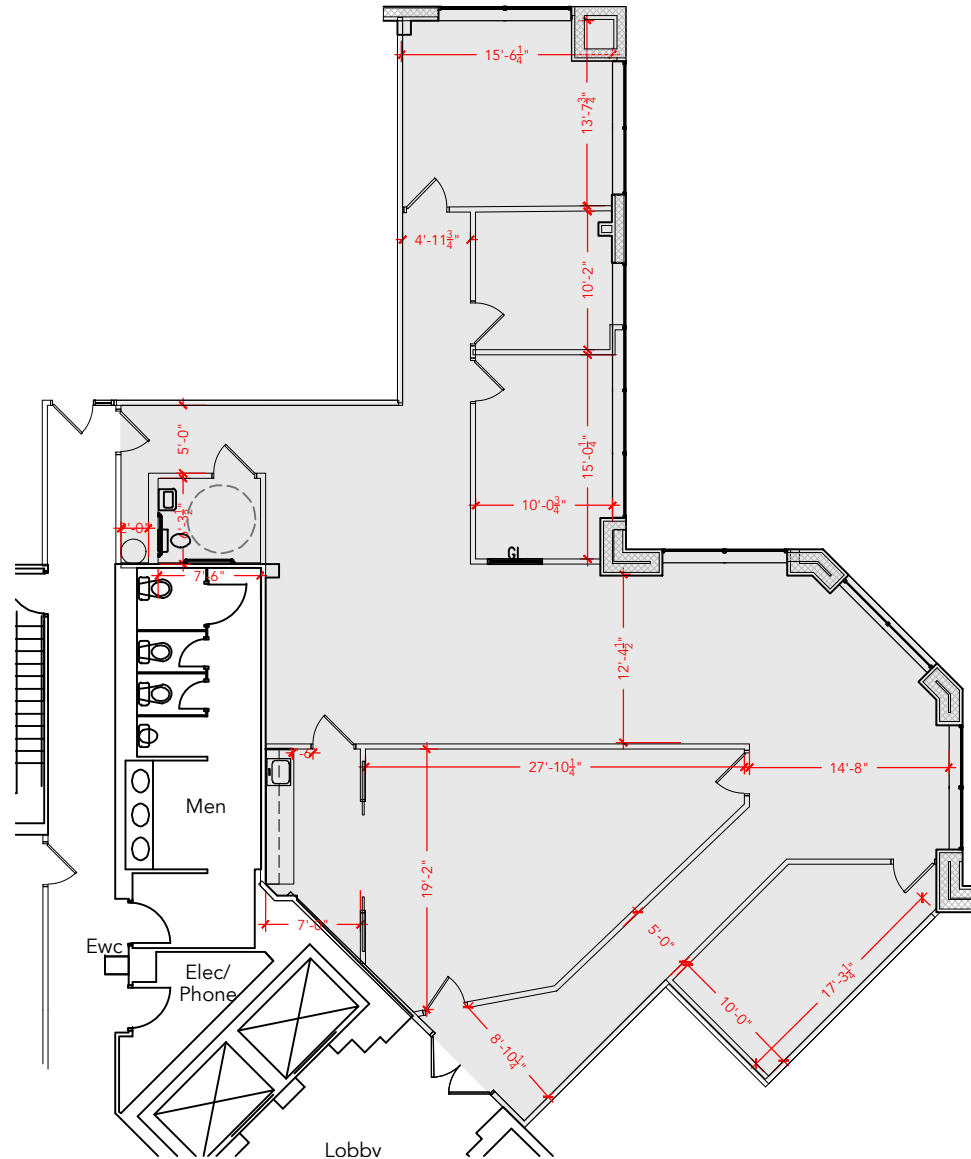

Floor Plan