



TOTAL SF AVAILABLE -1,567 RSF(12%)

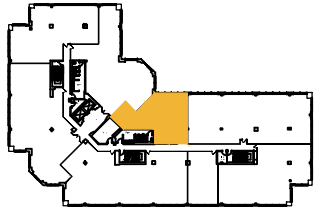

Key Plan

[Click to access 3D model](#)

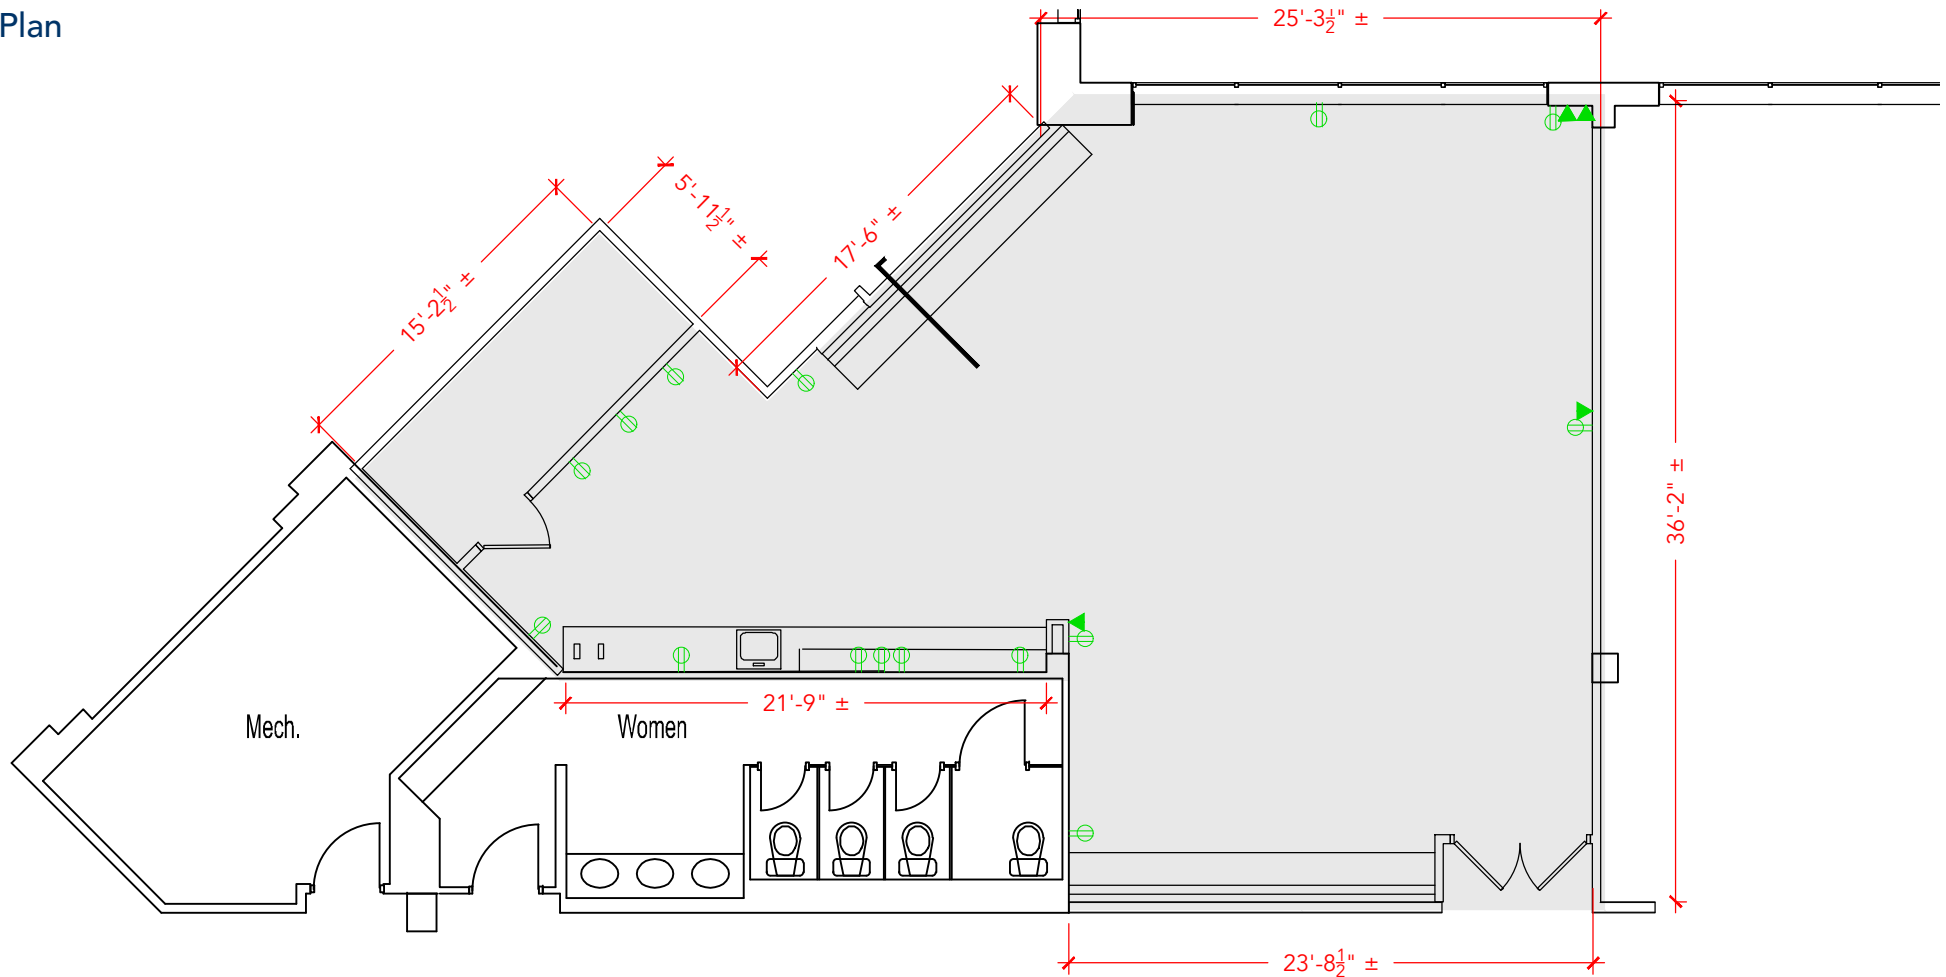

Floor Plan