
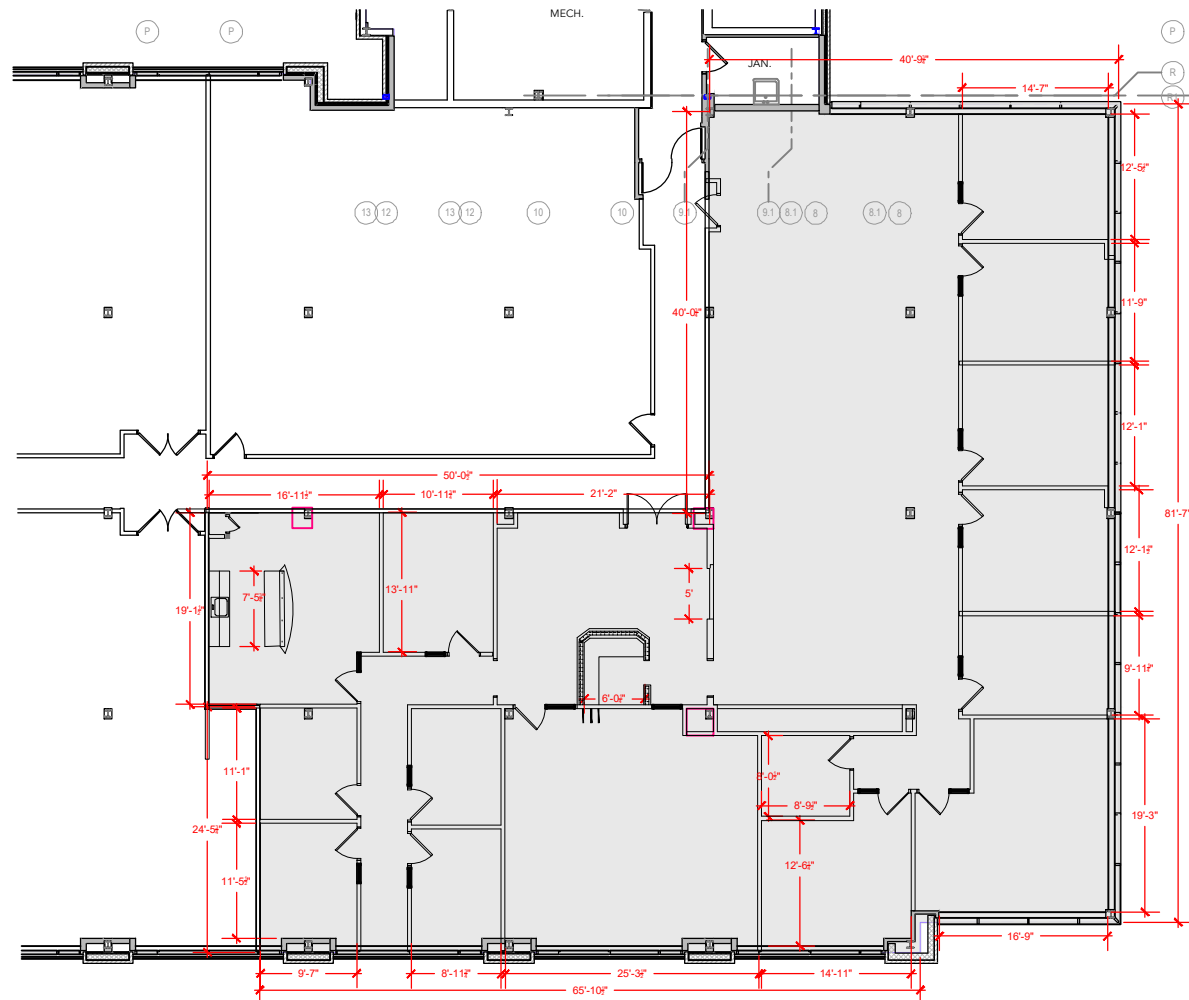


TOTAL SF AVAILABLE - 6,110 RSF(12%)

[Click to access CADD file](#)

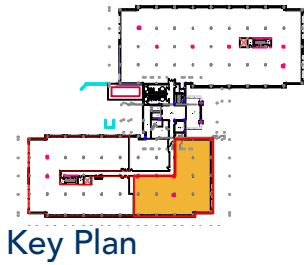

Floor Plan