
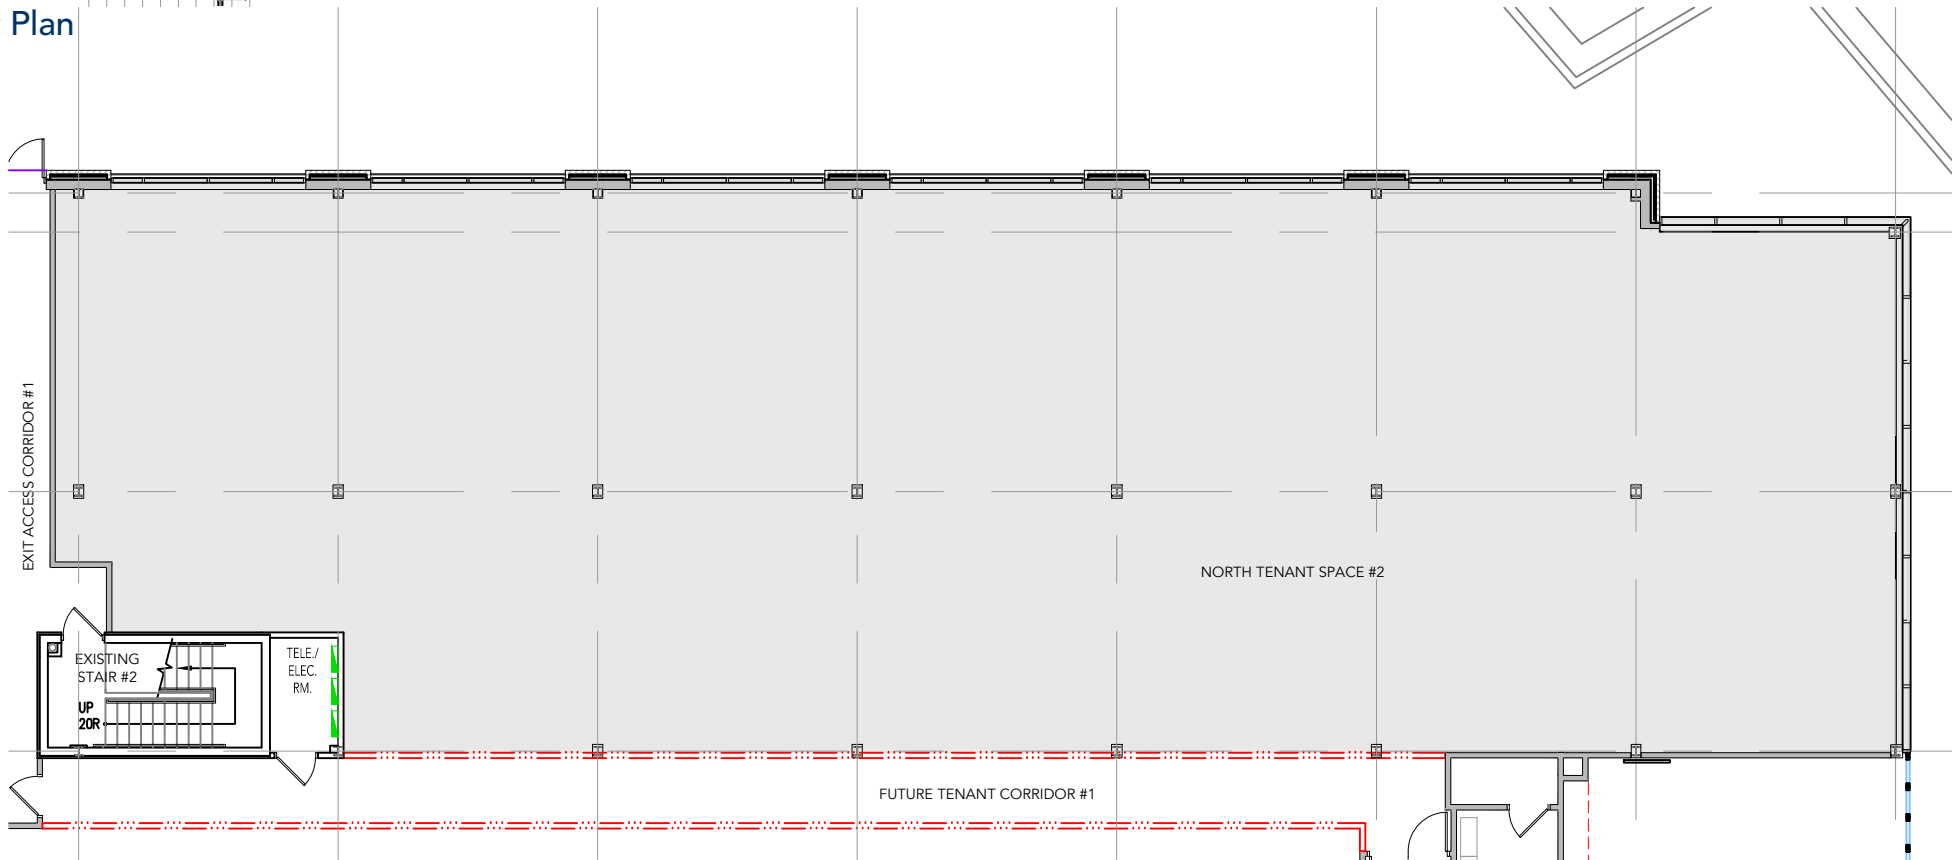


TOTAL SF AVAILABLE - 6,720 RSF(12%)

[Click to access 3D model](#)

Key Plan

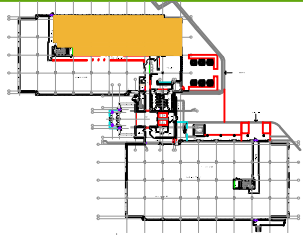

Floor Plan