


TOTAL SF AVAILABLE -3,219 RSF (12%)

[Click to access 3D model](#)



Key Plan

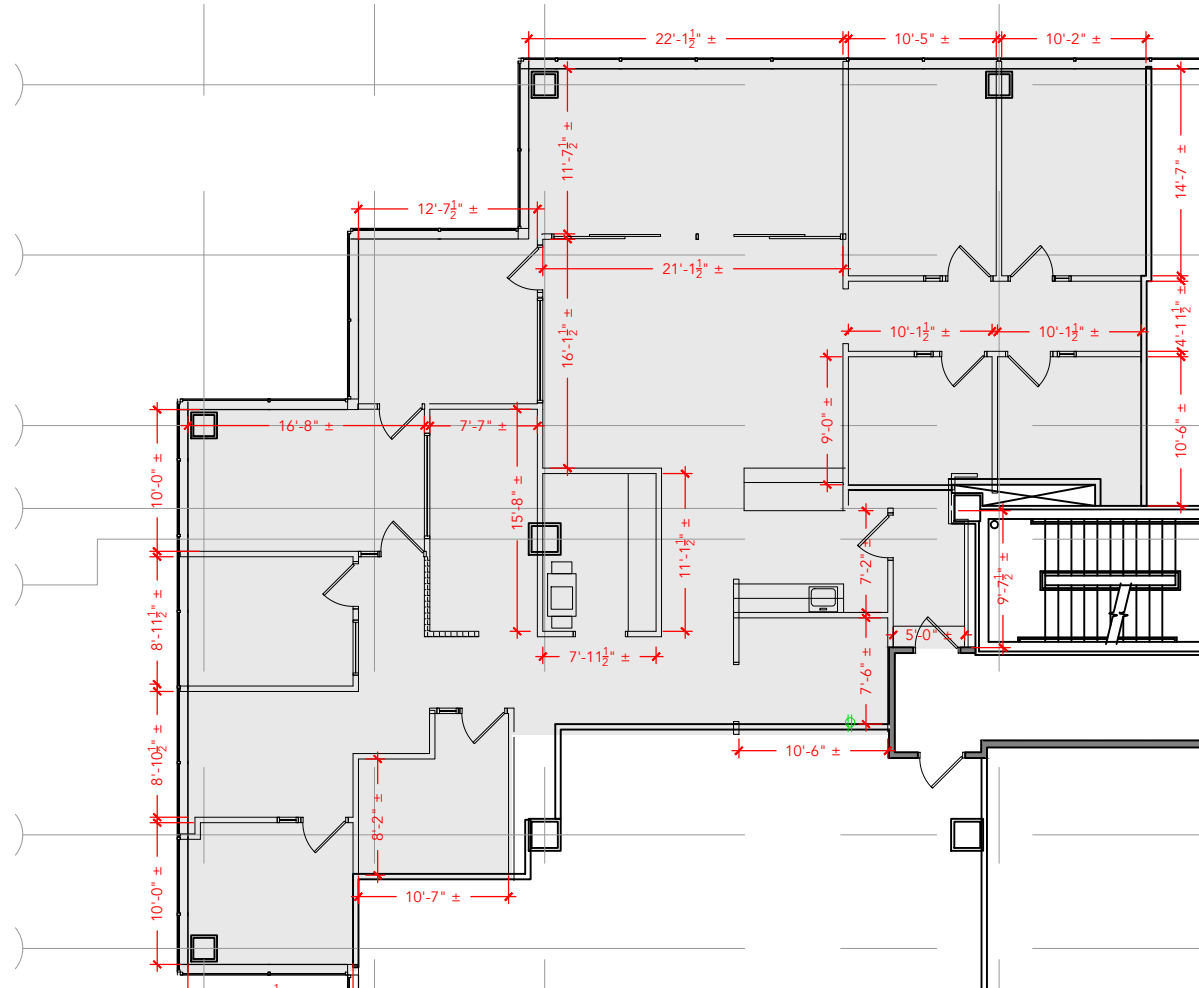

Floor Plan