


Key Plan

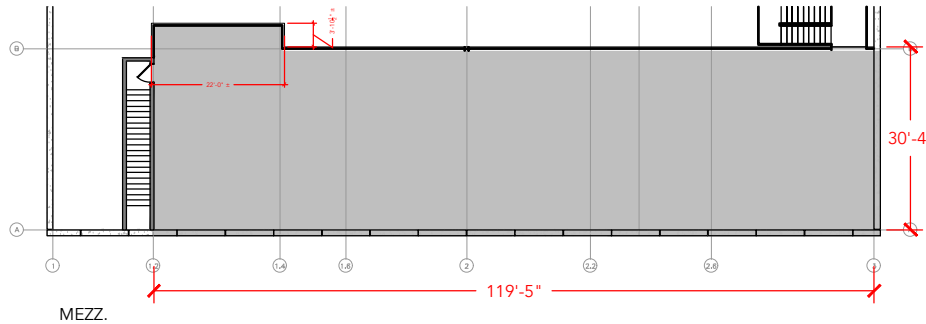


TOTAL SF AVAILABLE -15,634 SF

OFFICE - 3,778 SF

WAREHOUSE - 11,856 SF

* MEZZ 3,871 SF NOT INCLUDED IN TOTAL SF

[Click to access 3D model](#)

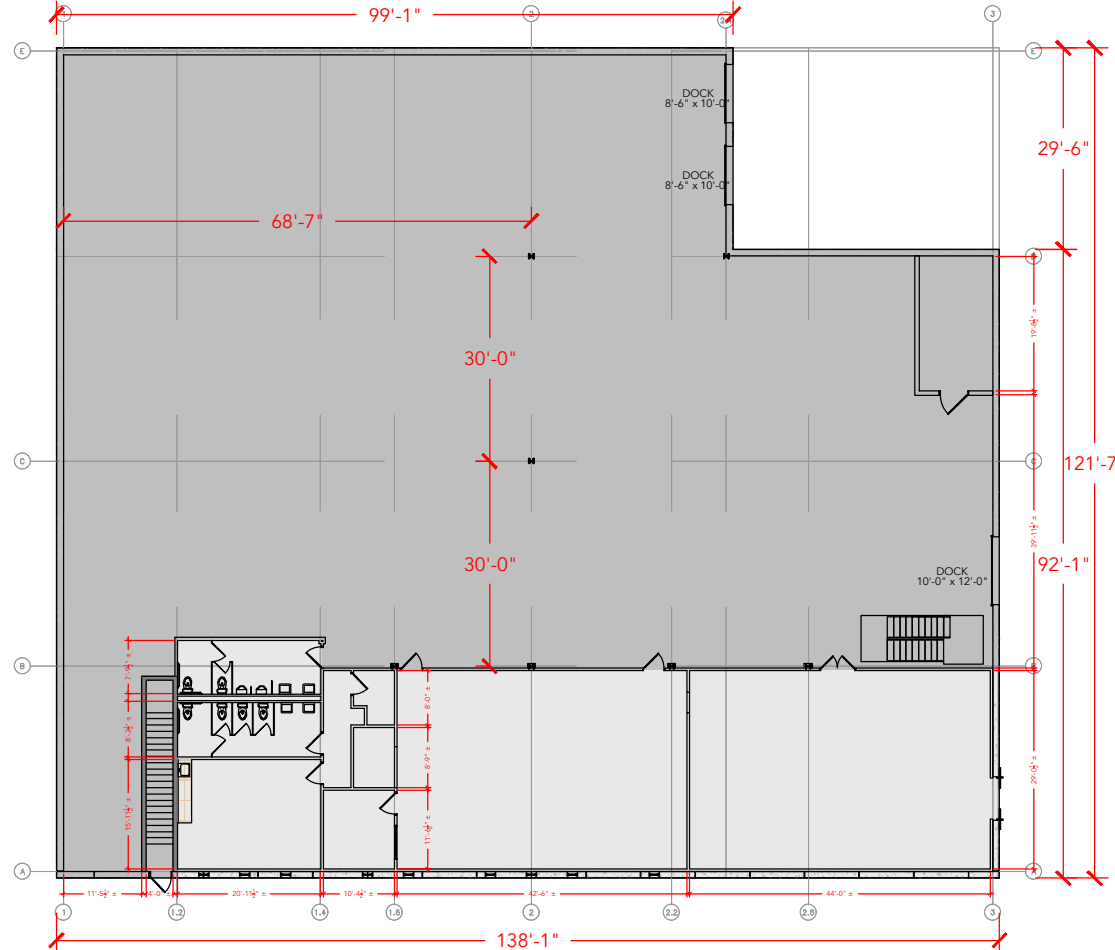

Floor Plan