


**TOTAL SF AVAILABLE - 13,576 SF**


OFFICE - 6,932 SF

WAREHOUSE SF - 6,644 SF

[Click to access 3D model](#)

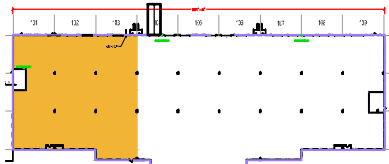

Key Plan

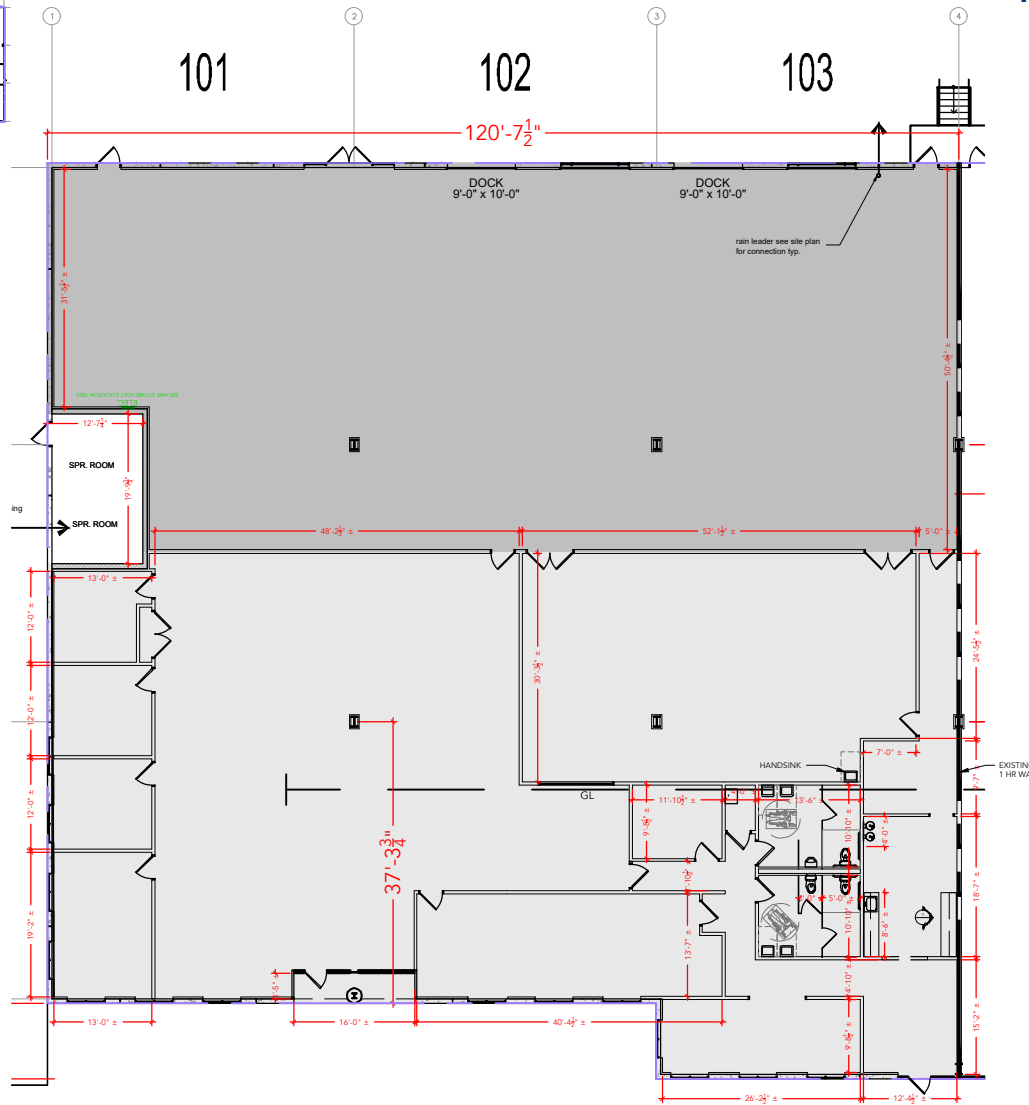

## Floor Plan