


**TOTAL SF AVAILABLE -19,599 RSI**

**OFFICE - 19,599 RSF**


**WAREHOUSE - 0,000 SF**

\* INCLUDES % OF METER ROOM

[Click to access 3D model](#)

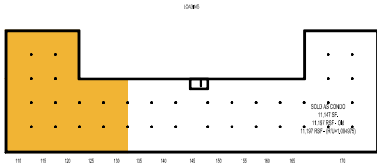

Key Plan

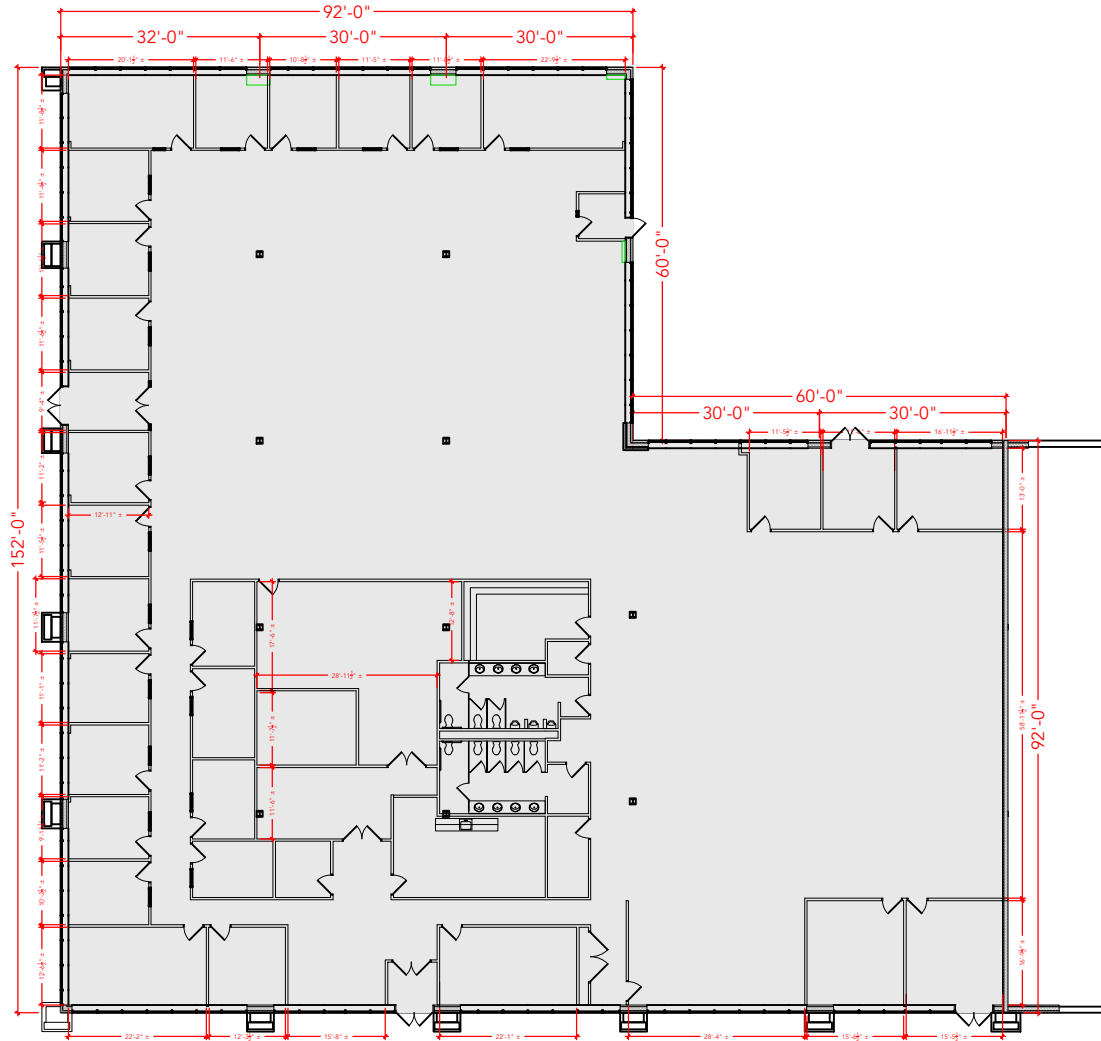

Floor Plan