


TOTAL SF AVAILABLE - 3,319 RSF


OFFICE - 1,551 RSF

WAREHOUSE - 1,768 RSF

* INCLUDED % OF MECH. ROOM

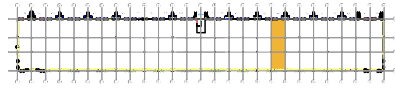

Key Plan

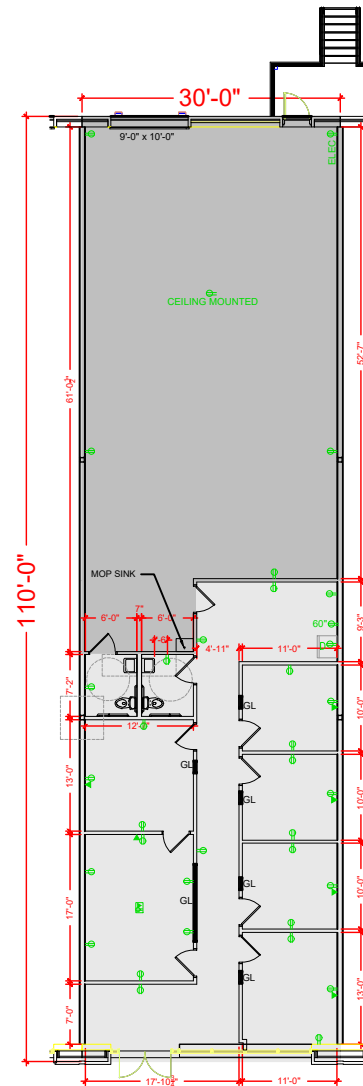

Floor Plan