

Key Plan

TOTAL SF AVAILABLE - 3,319 RSF

OFFICE - 1,159 RSF


WAREHOUSE - 2,160 RSF

* INCLUDED % OF MECH. ROOM

[Click to access 3D model](#)

Floor Plan

PLAN NOT TO SCALE - THIS IS NOT A CONSTRUCTION DOCUMENT

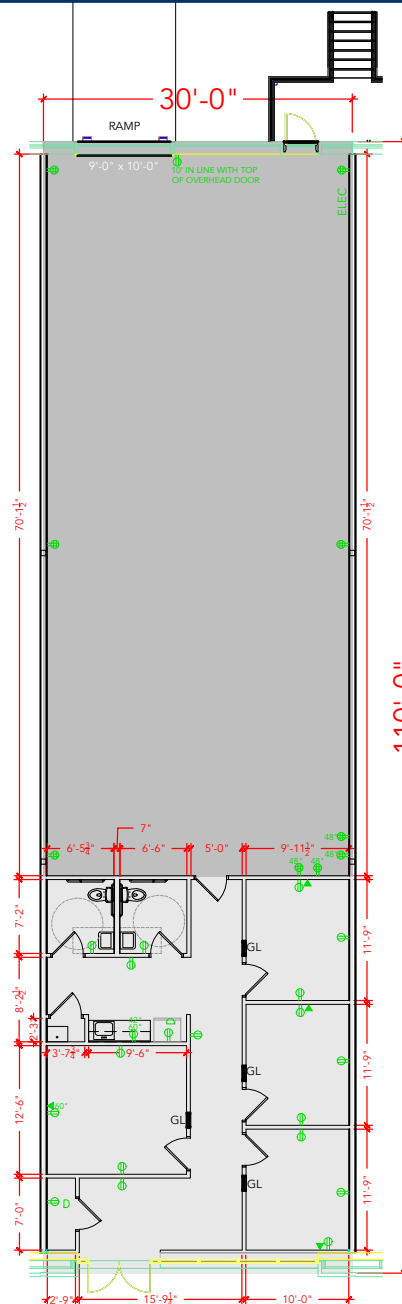

DRAWING #: WF1-C1-119 ASBUILT DATE: **NEEDS TO BE**