



100                      101                      102      TOTAL SF AVAILABLE - 12,070 RSF

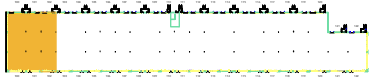

Key Plan

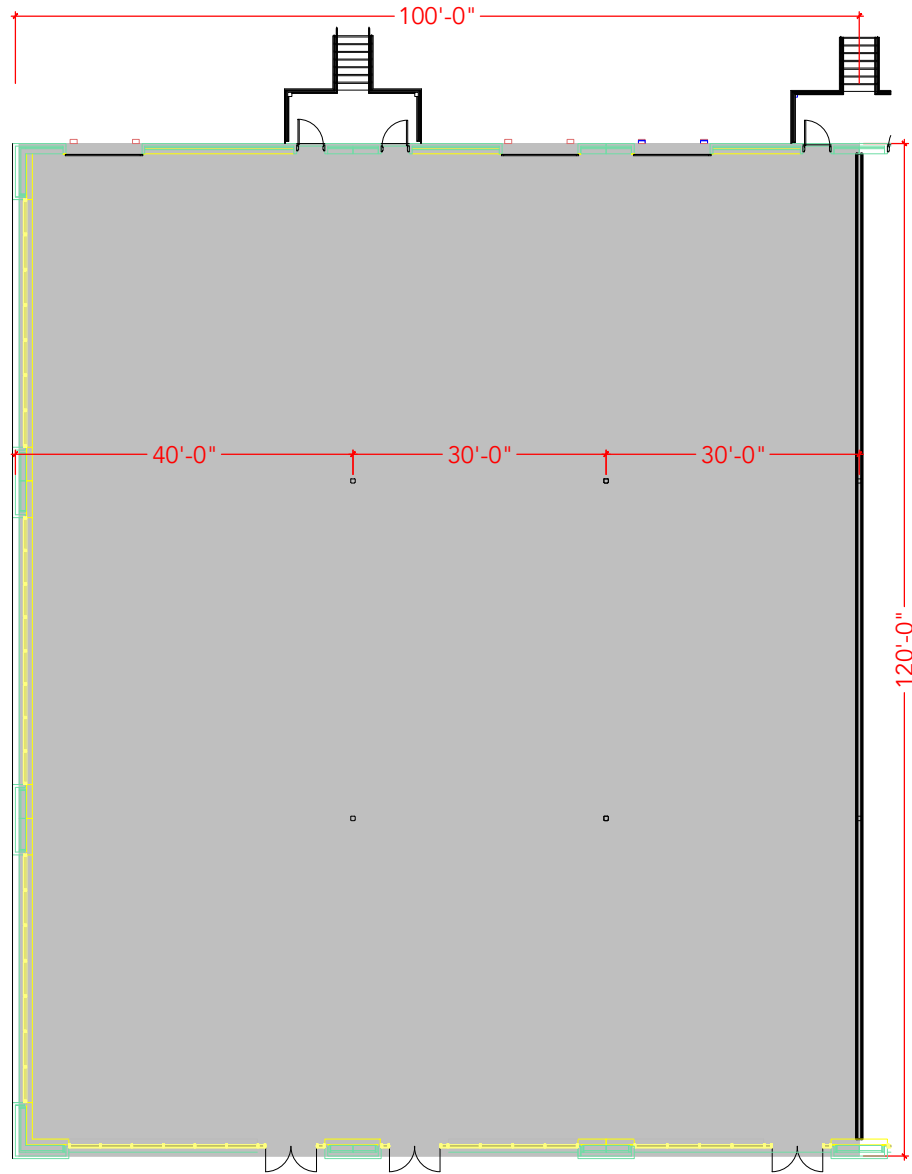

Floor Plan