


TOTAL SF AVAILABLE - 1,773 RSF

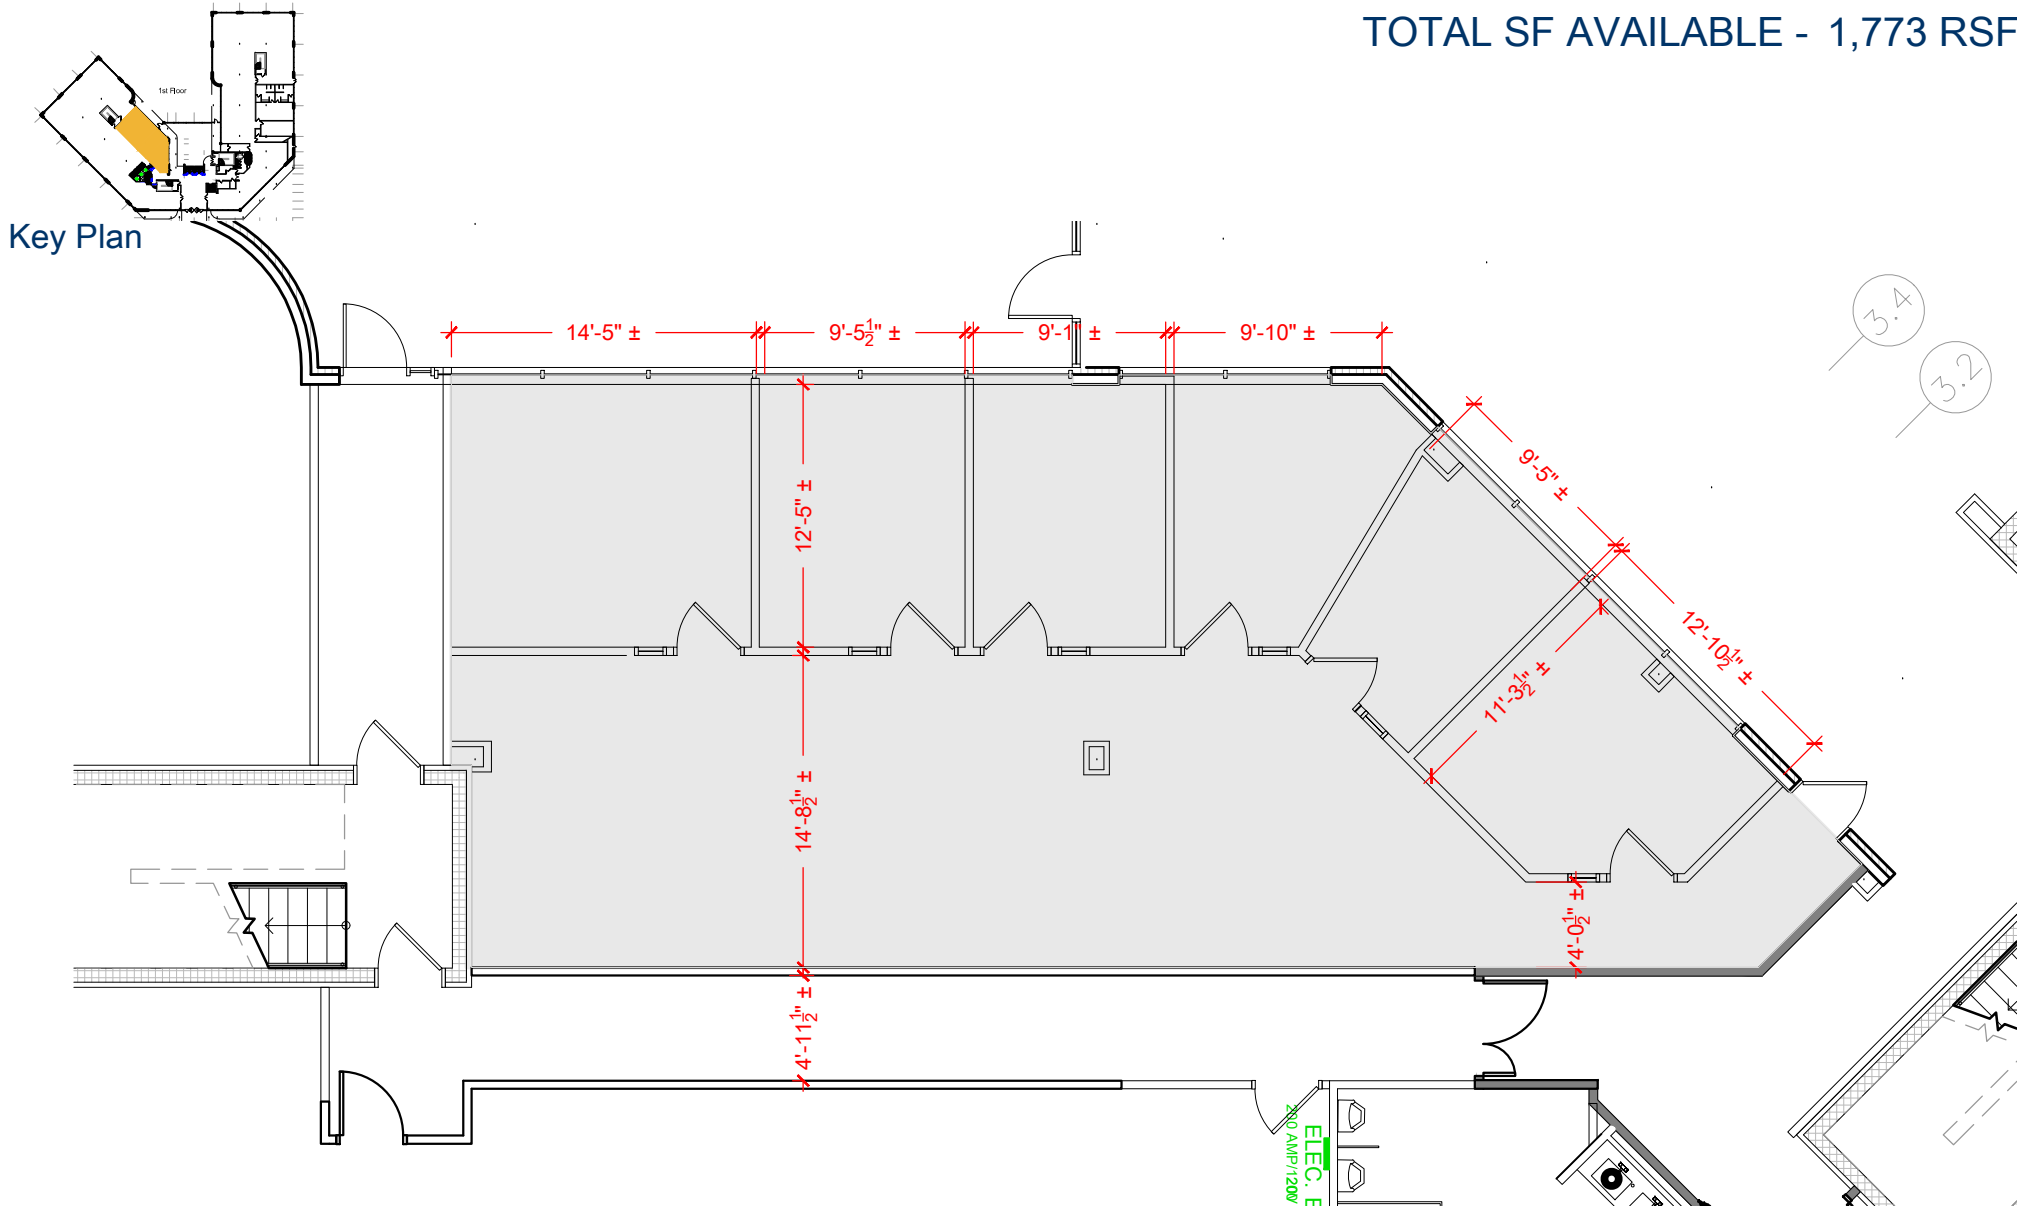

Floor Plan