



TOTAL SF AVAILABLE -5,102 RSF(12%)

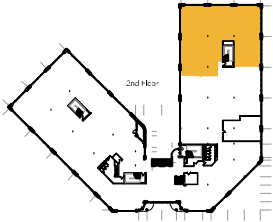

Key Plan

[Click to access CADD file](#)

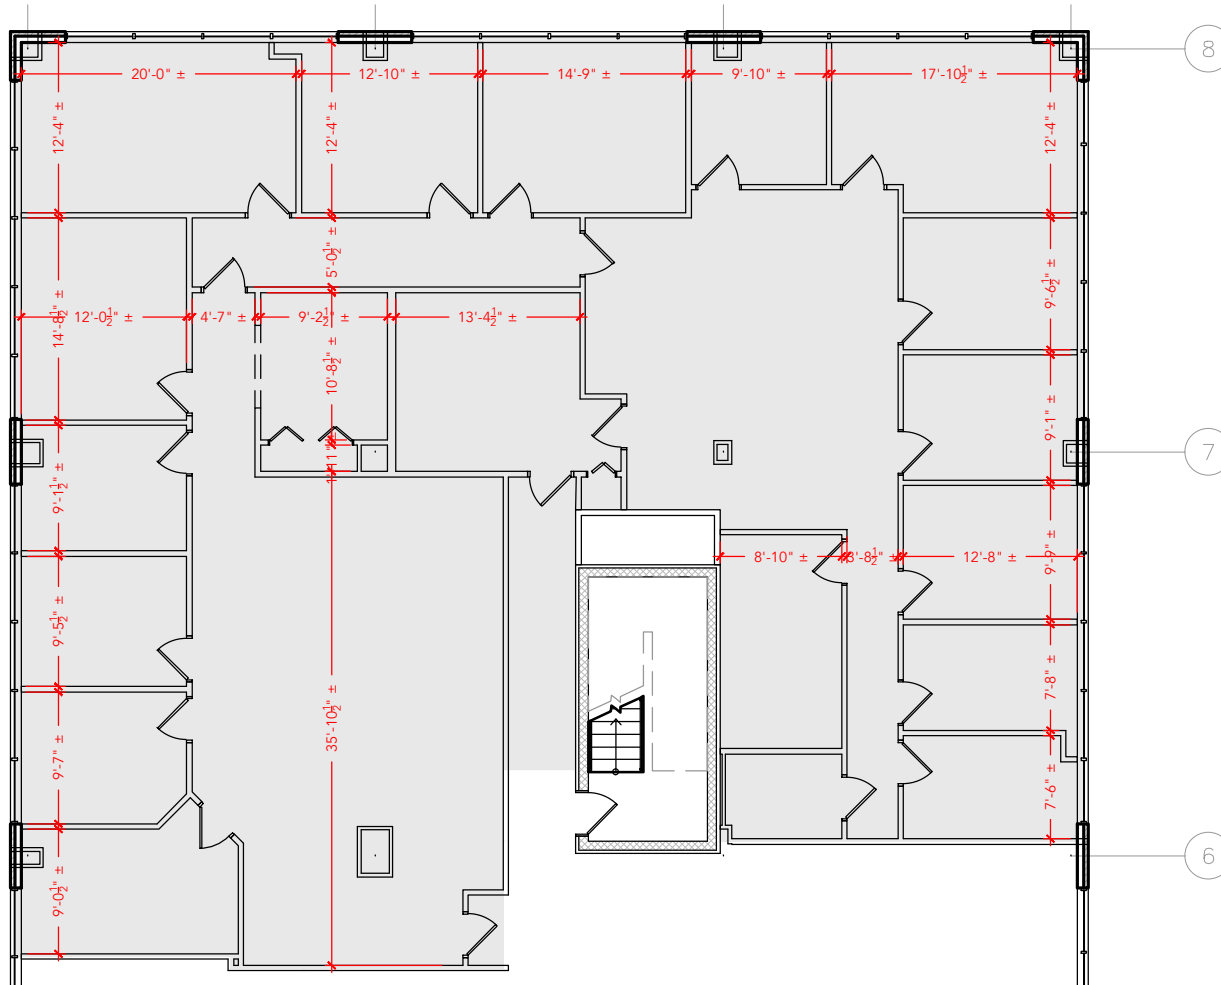

Floor Plan