



**TOTAL SF AVAILABLE -18,000 SF**

OFFICE - 1,324 SF  
WAREHOUSE - 16,676 SF

[Click to access 3D model](#)

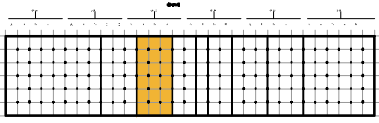

## Key Plan

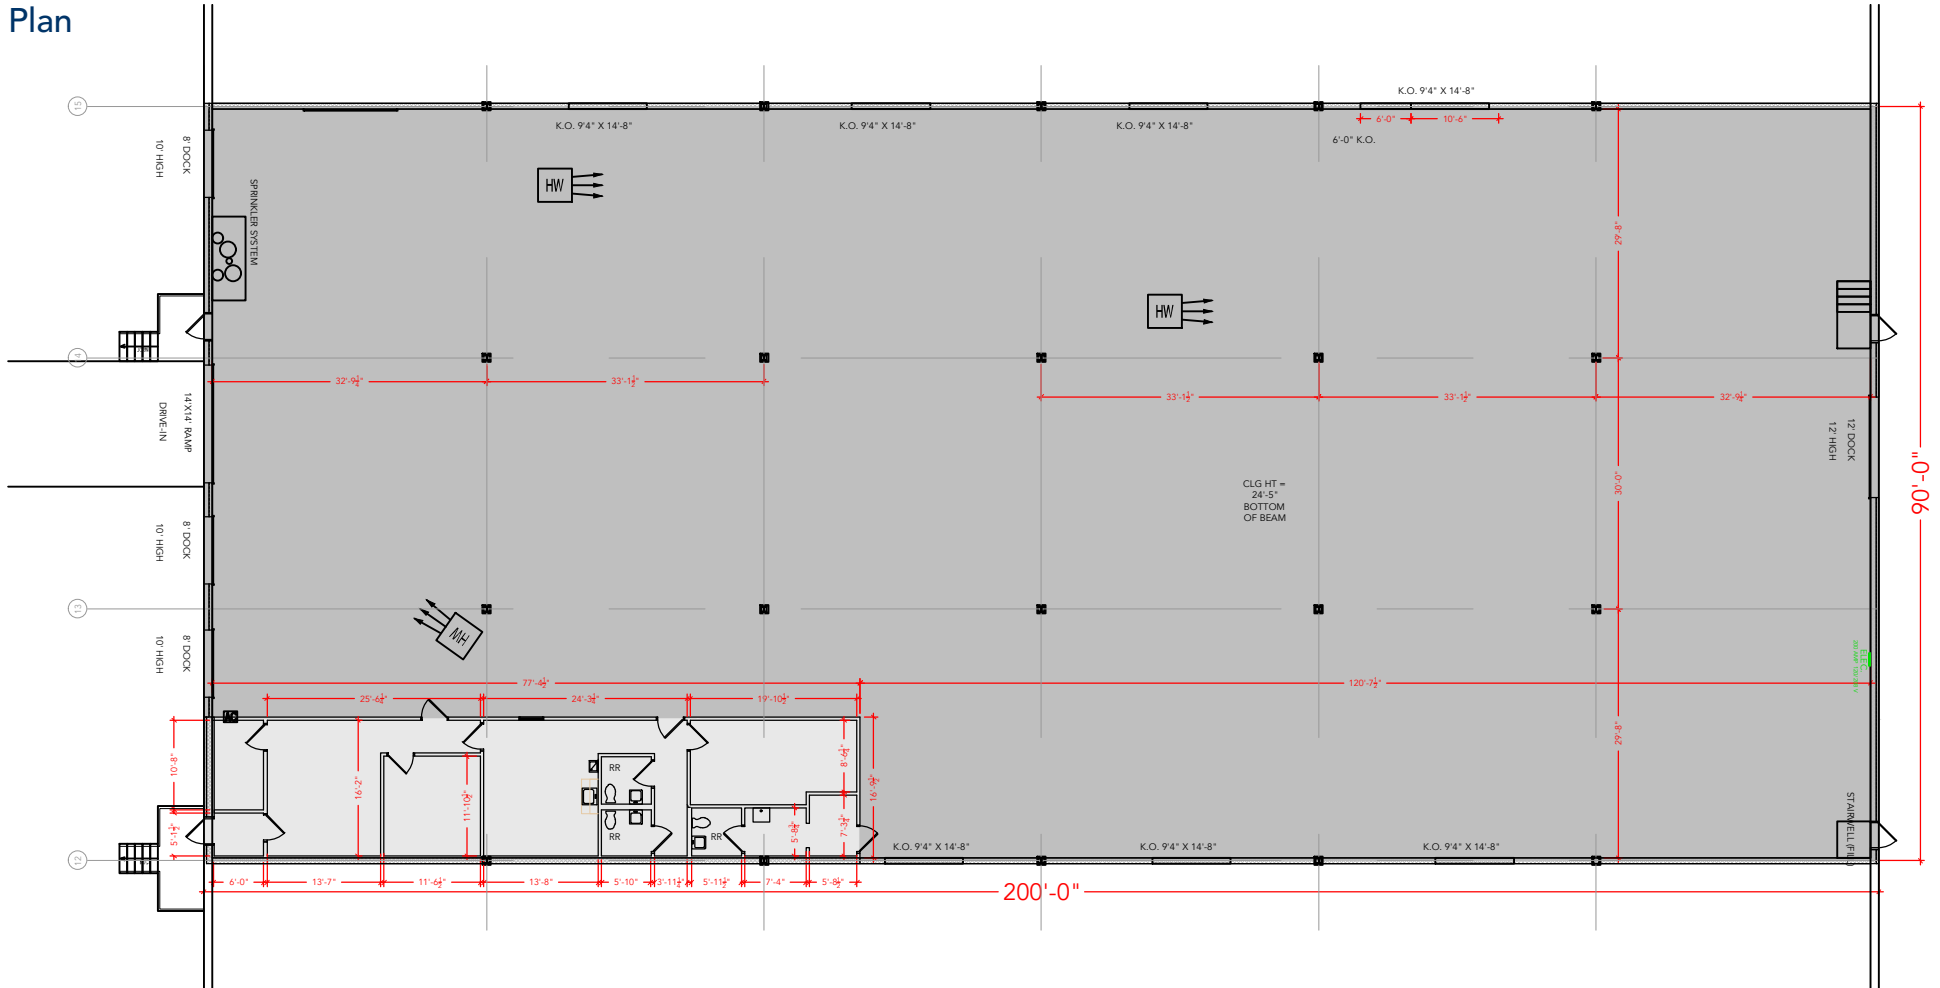

## Floor Plan