



COLUMBIA CORPORATE PARK

8850 STANFORD BLVD. COLUMBIA, MD 21045 SUITES 4500-4600

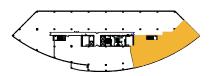

TOTAL SF AVAILABLE - 5,408 RSF (16%)

Key Plan

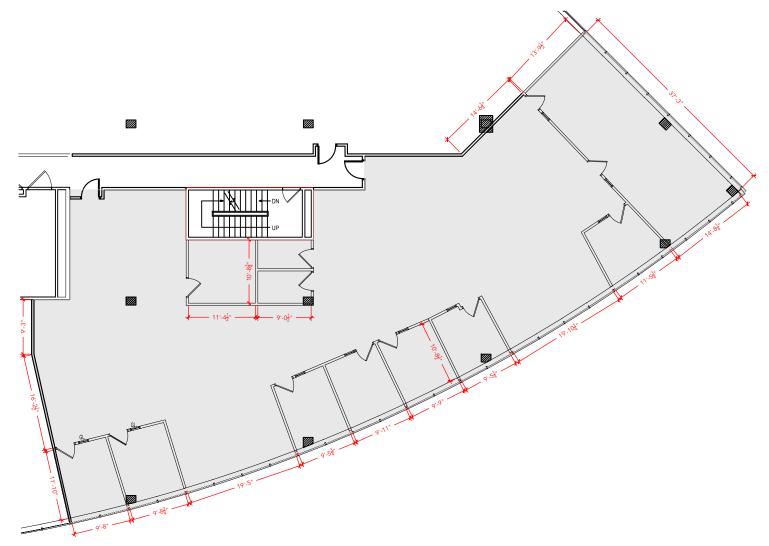

Floor Plan