



TOTAL SF AVAILABLE -2,100 SF

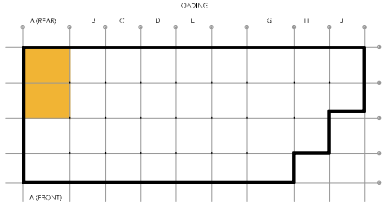

Key Plan

A (REAR)

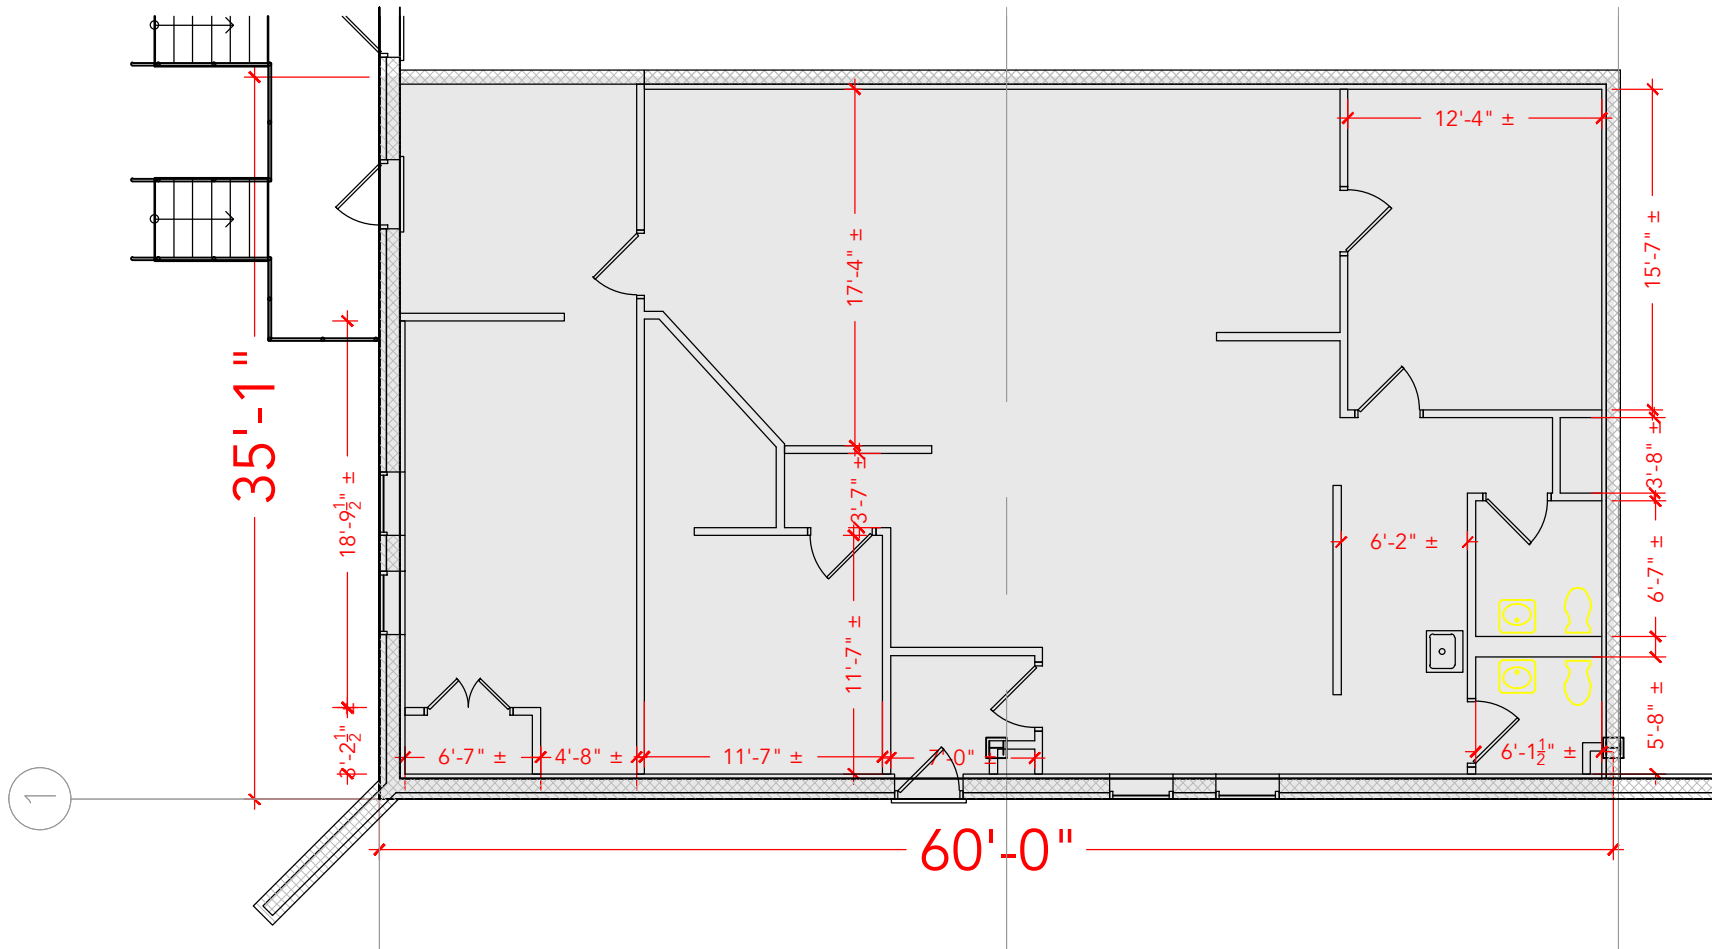

Floor Plan