PULASKI BUSINESS PARK 4

9601 PULASKI PARK DR BALTIMORE, MD 21220

SUITE 408-409

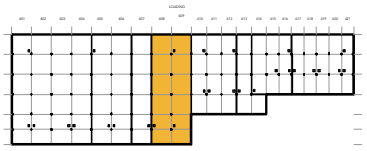

TOTAL SF AVAILABLE -17,600 SF

OFFICE - 3,162 SF

WAREHOUSE - 14,438 SF

Click to access **CADD file**

Key Plan

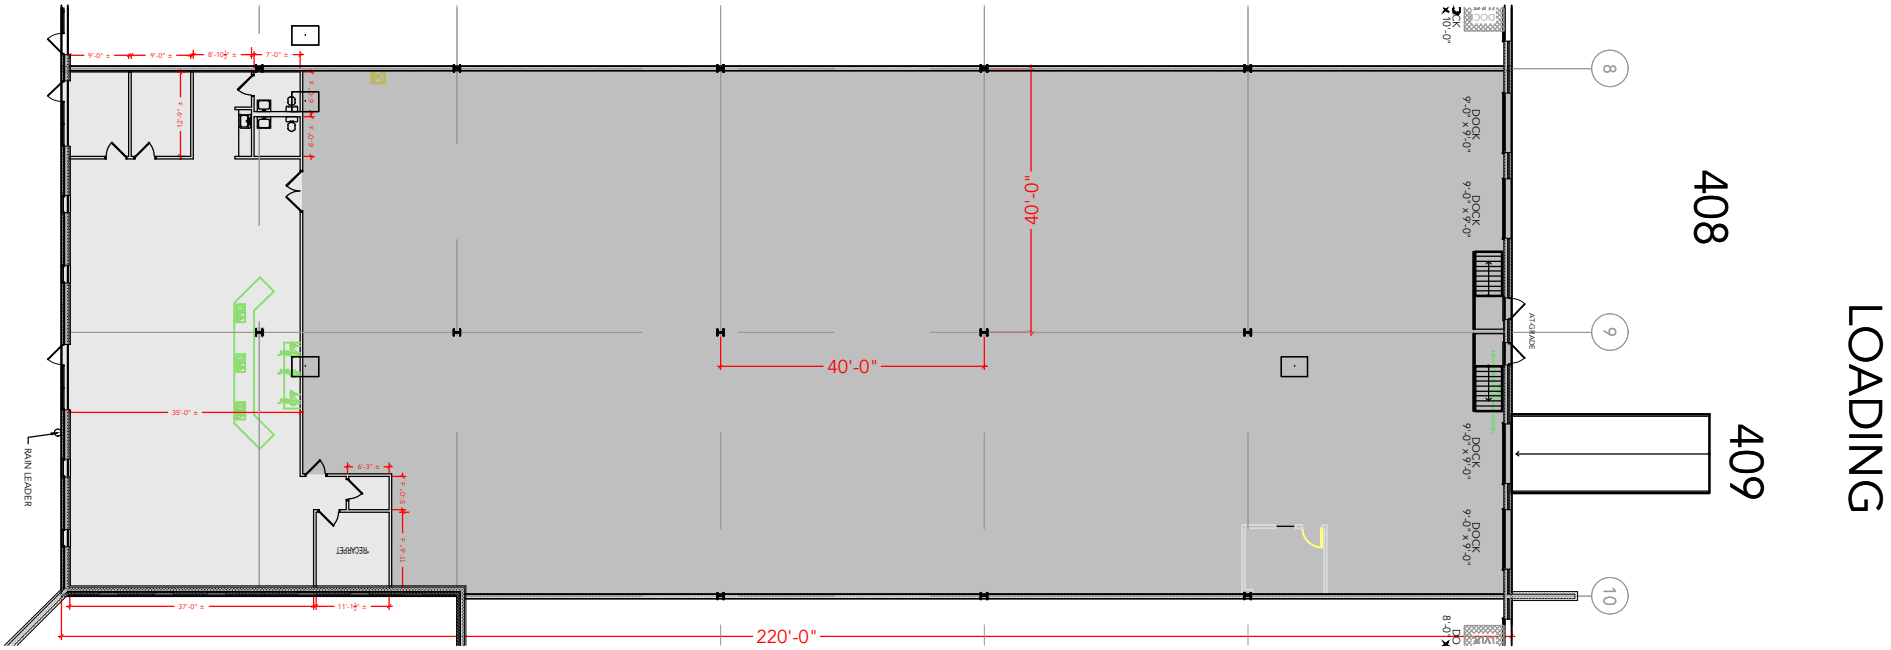

Floor Plan

PLAN NOT TO SCALE - THIS IS NOT A CONSTRUCTION DOCUMENT

DRAWING #: 038B-9601-408-409 ASBUILT DATE: **04.13.01**