BLADES LANE

150 BLADES LANE, GLEN BURNIE, MD 21061

SUITE F-G



TOTAL SF AVAILABLE - 5,100 SF

OFFICE - 2,859 SF

WAREHOUSE SF - 2,241 SF

Key Plan

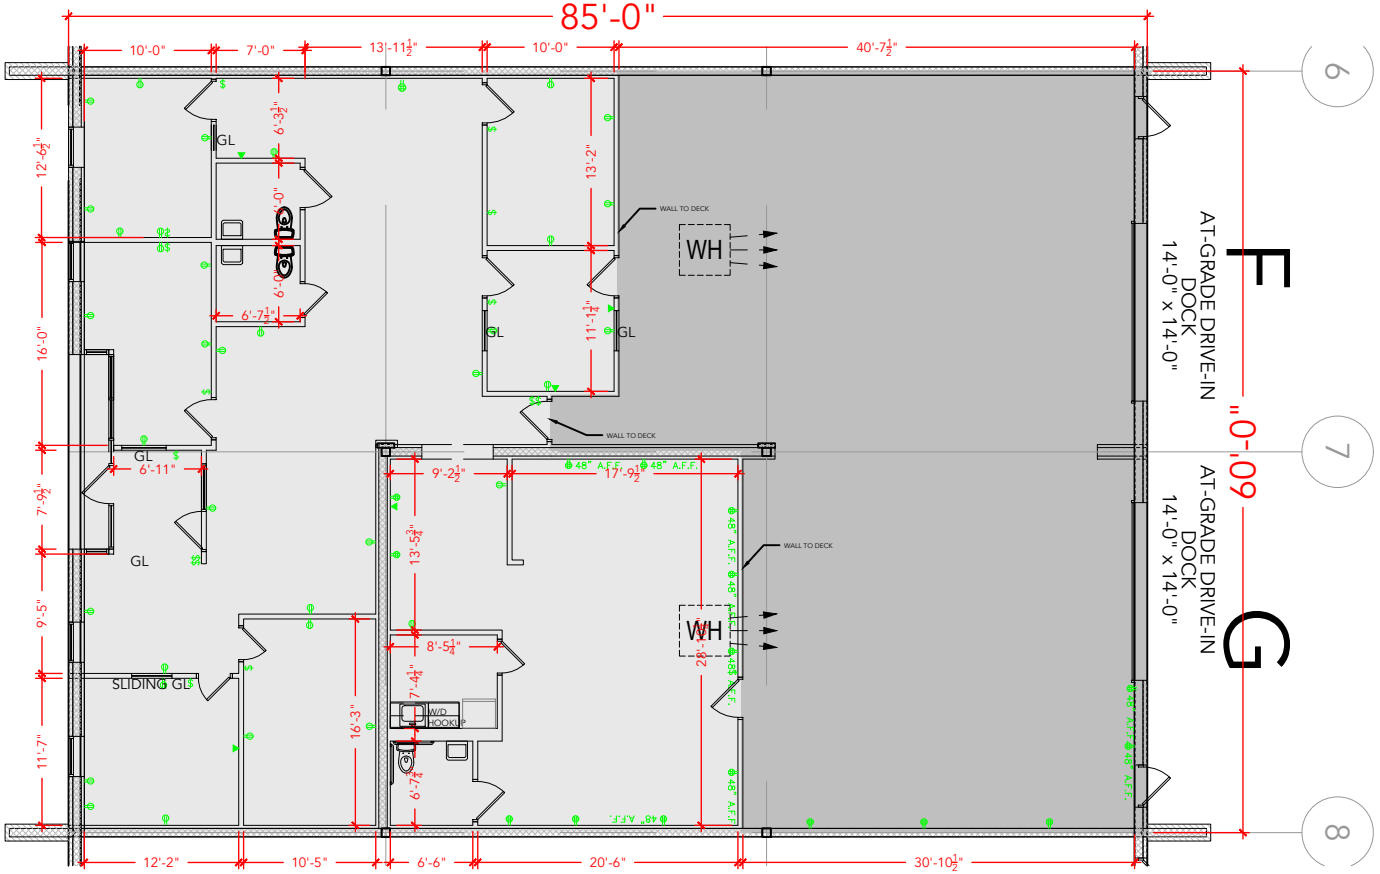

Floor Plan

PLAN NOT TO SCALE - THIS IS NOT A CONSTRUCTION DOCUMENT

DRAWING #: 089-150-F-G ASBUILT DATE: **NEEDS TO BE**