COLUMBIA CORPORATE PARK

8830 STANFORD BLVD. COLUMBIA, MD 21045

SUITE LL70-LL80

TOTAL SF AVAILABLE -4,369 RSF (16%)

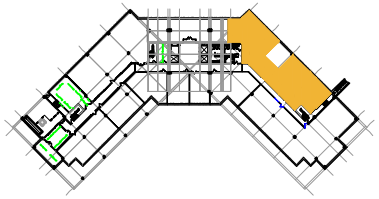

Key Plan

Click to access **CADD file**

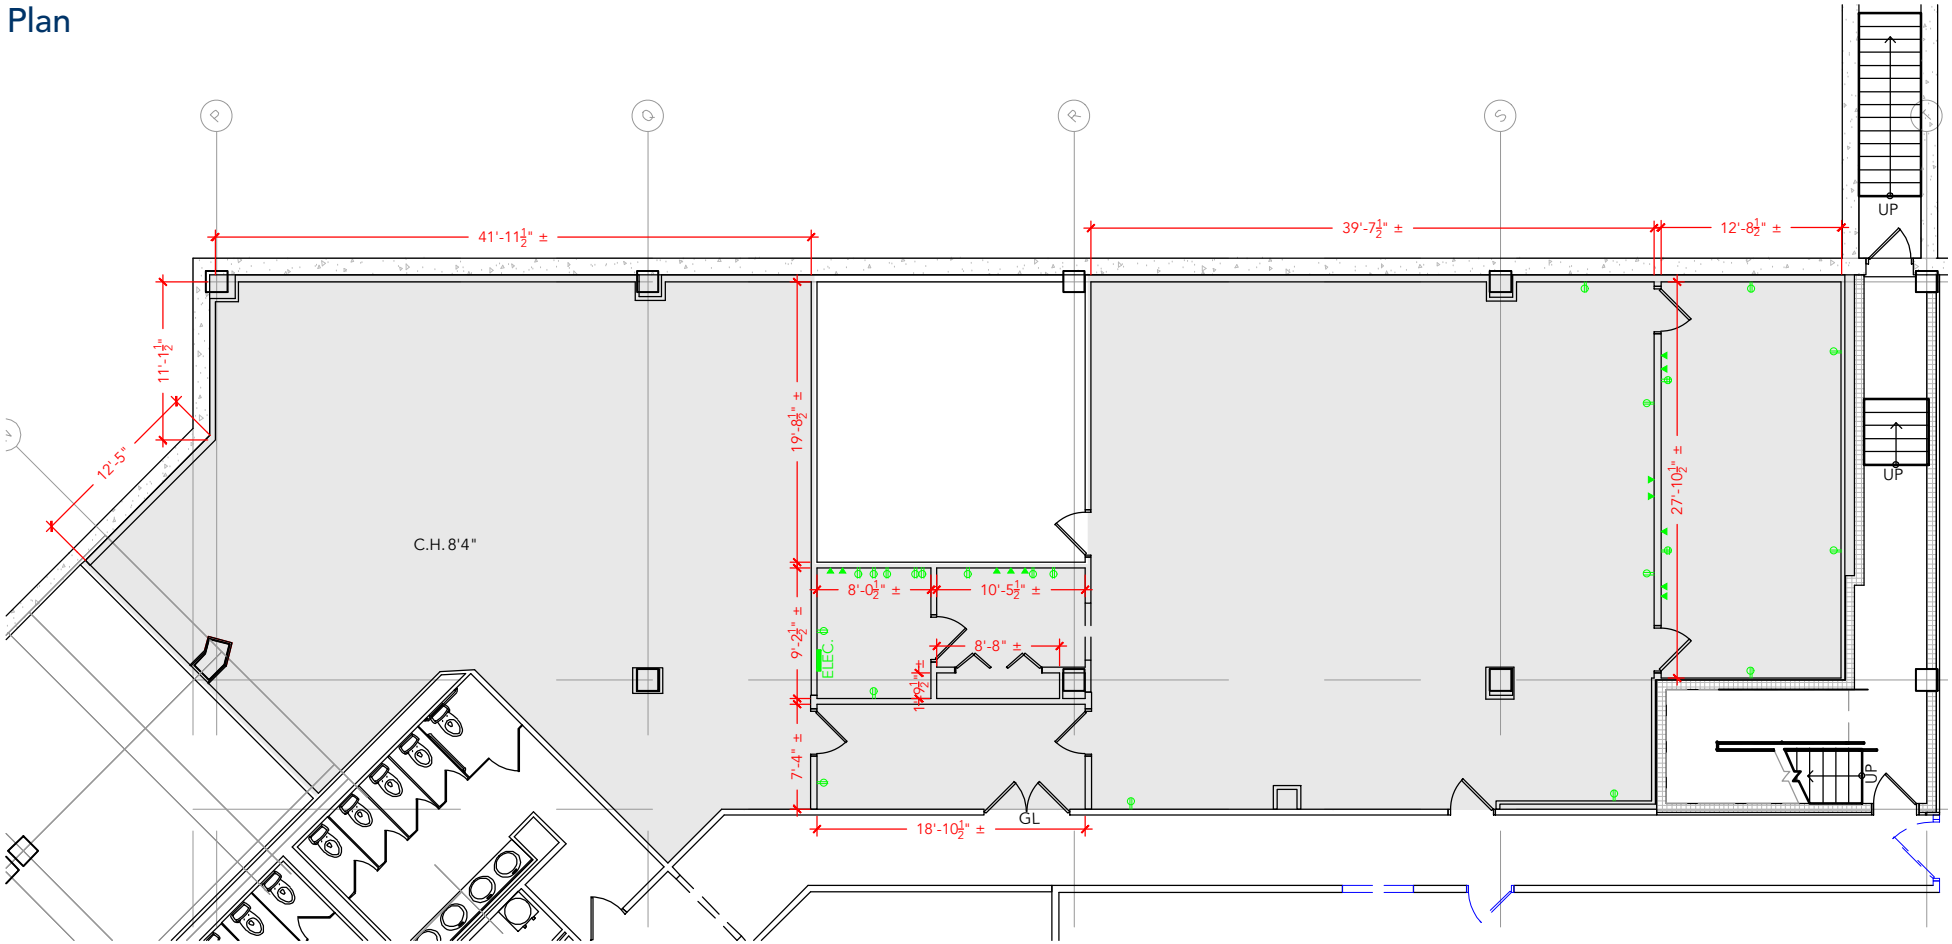

Floor Plan

PLAN NOT TO SCALE - THIS IS NOT A CONSTRUCTION DOCUMENT

DRAWING #: BH3-LL70-LL80 ASBUILT DATE: **08.10.2023**