BALTIMORE COMMONS

7483 CANDLEWOOD ROAD, HANOVER, MD 21076

SUITE J-N

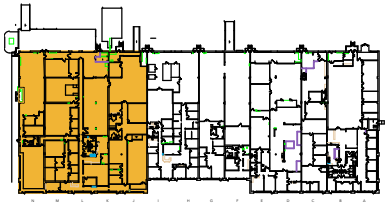

Key Plan

TOTAL SF AVAILABLE - 24,801 RSF

OFFICE - 0,000 SF

WAREHOUSE - 24,801 RSF

* INCLUDES % OF METER ROOM

Click to access **CADD file**

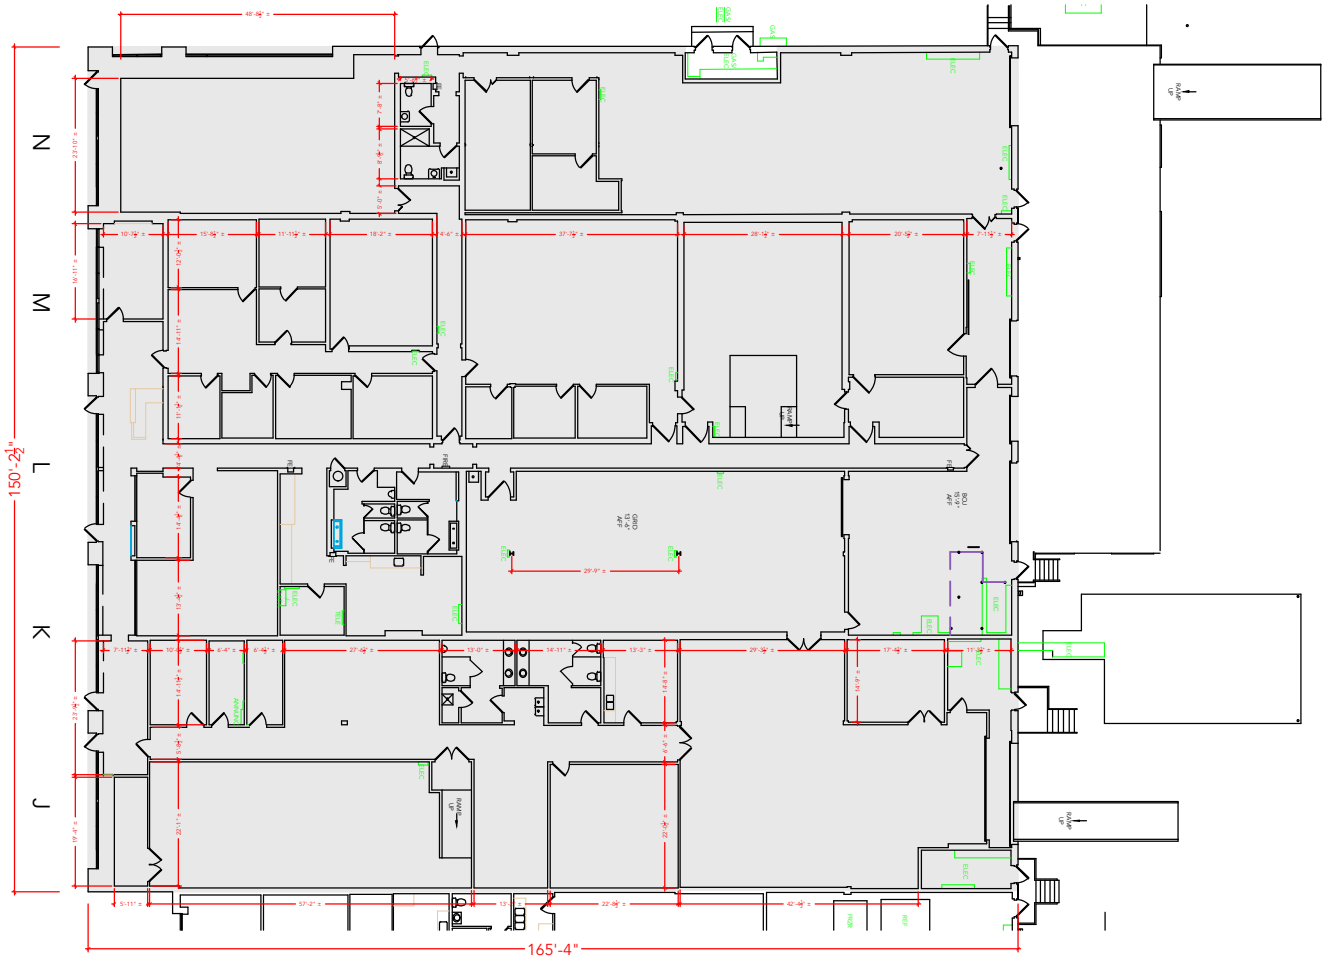

Floor Plan

PLAN NOT TO SCALE - THIS IS NOT A CONSTRUCTION DOCUMENT

DRAWING #: CR1-J-N ASBUILT DATE:NEEDS TO BE