merritt PROPERTIES

CCP 100

6021 UNIVERSITY BLVD. ELLICOTT CITY, MD 21043
SUITE 100-130

TOTAL SF AVAILABLE -11,080 RSF (16%)

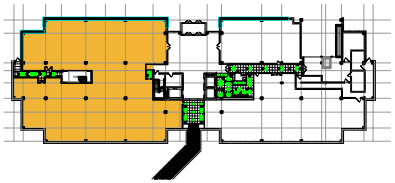

Key Plan

Click to access **CADD file**

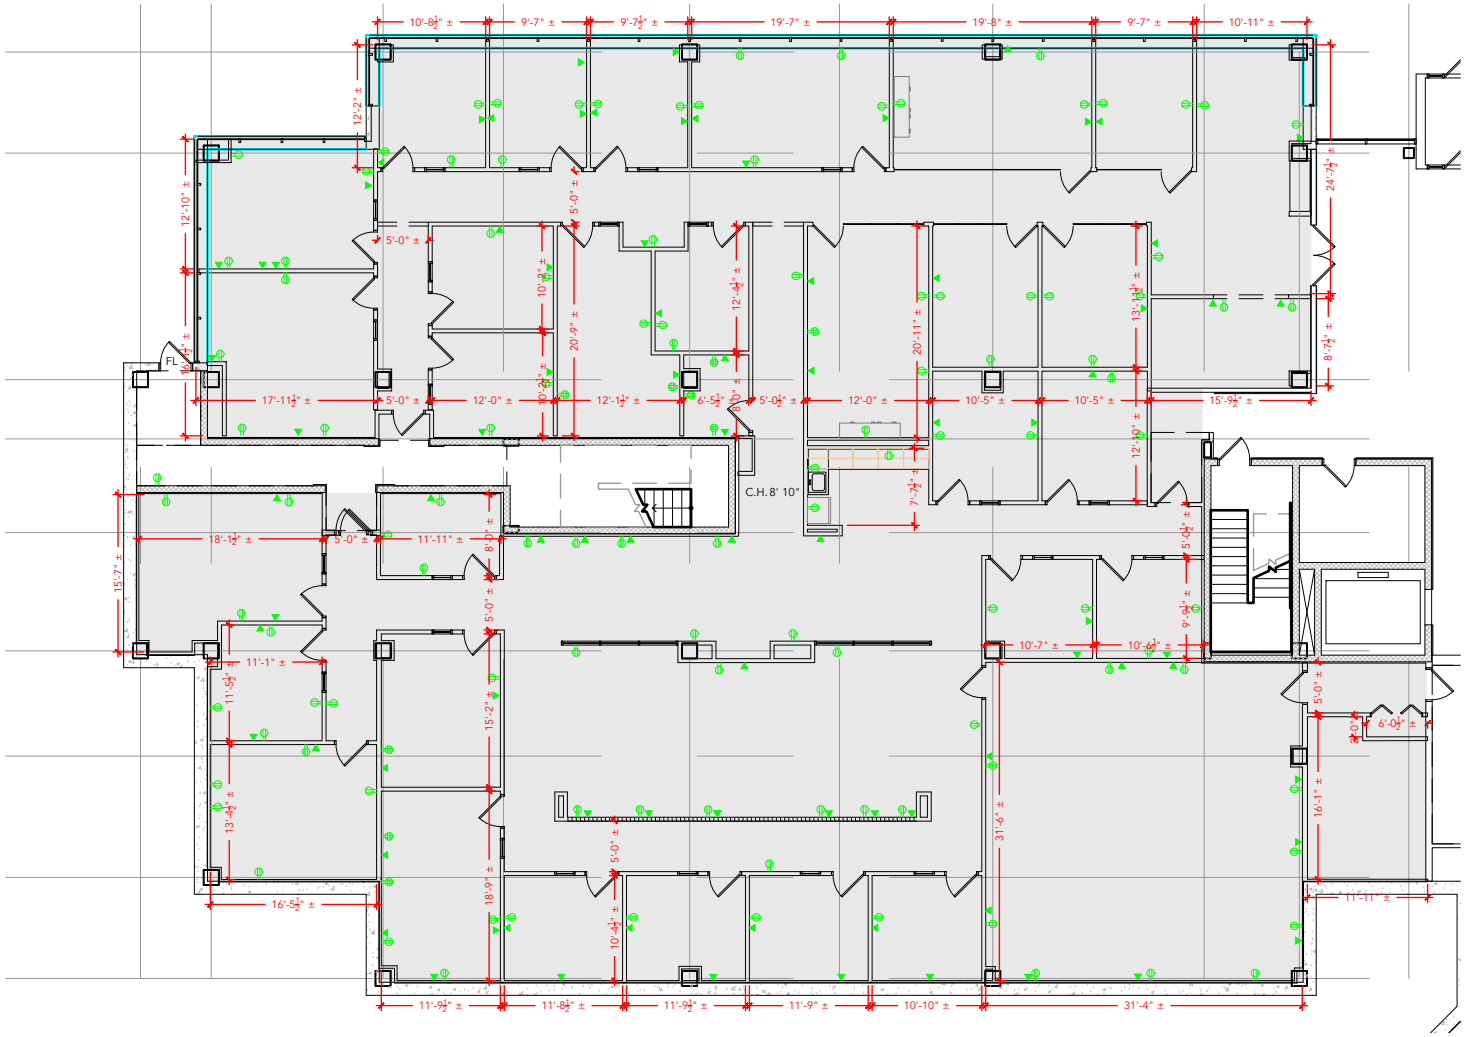

Floor Plan

PLAN NOT TO SCALE - THIS IS NOT A CONSTRUCTION DOCUMENT

DRAWING #: HF3-100-130 ASBUILT DATE: **02.06.2023**