MEADOWRIDGE 95 - BUILDING 2

6518 MEADOWRIDGE RD ELKRIDGE, MD 21075

SUITE 234

TOTAL SF AVAILABLE -2,583 RSF(16%)

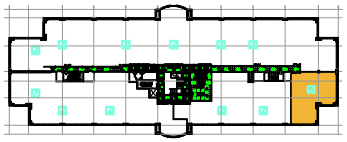

Click to access **CADD file**

Key Plan

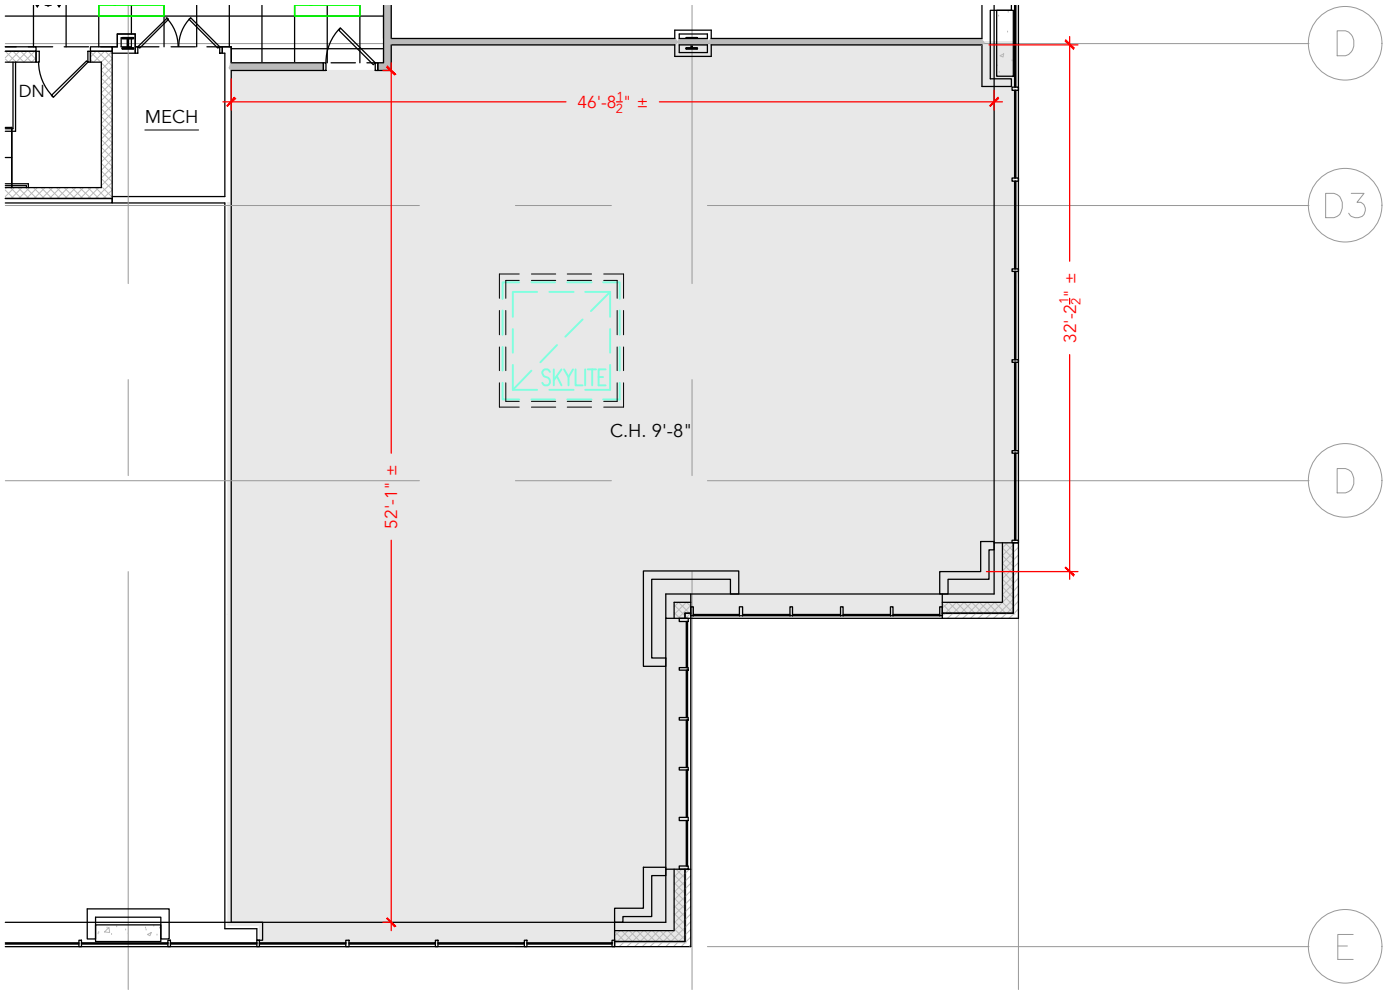

Floor Plan

PLAN NOT TO SCALE - THIS IS NOT A CONSTRUCTION DOCUMENT

DRAWING #: MR2-234 ASBUILT DATE: 03.31.2026