MEADOWRIDGE 95 - BUILDING 2

6518 MEADOWRIDGE RD ELKRIDGE, MD 21075

SUITE 236-242

TOTAL SF AVAILABLE -5,682 RSF (16%)

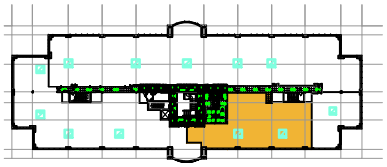

Click to access **CADD file**

Key Plan

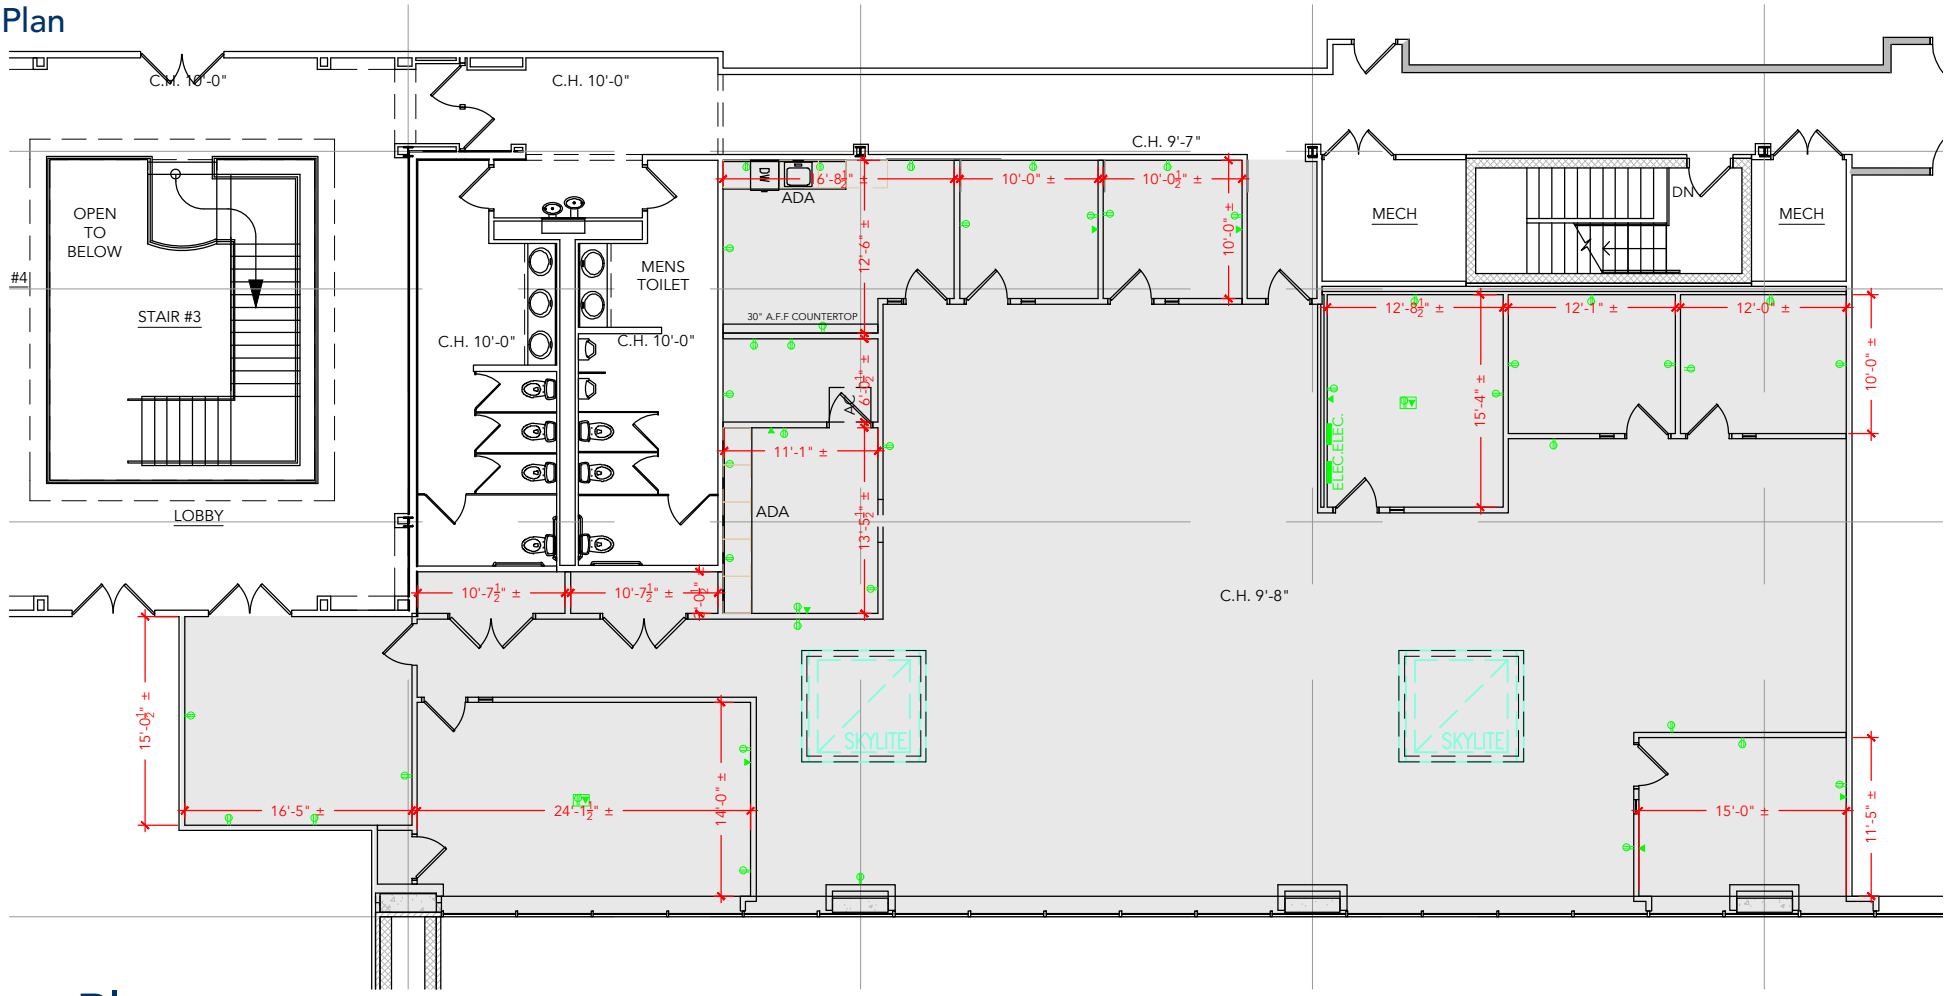

Floor Plan

PLAN NOT TO SCALE - THIS IS NOT A CONSTRUCTION DOCUMENT

DRAWING #: MR2-236-242 ASBUILT DATE: **09.29.2026**