RDU BUSINESS PARK WEST POD

2050 SEAGIRT AVE, MORRISVILLE, NC 27560

SUITES 100-195



TOTAL SF AVAILABLE -72,000 RSF

OFFICE - 0,000 SF

WAREHOUSE - 72,000 RSF

* % OF MECH ROOM INCLUDED IN RSF

Click to access **CADD file**

Key Plan

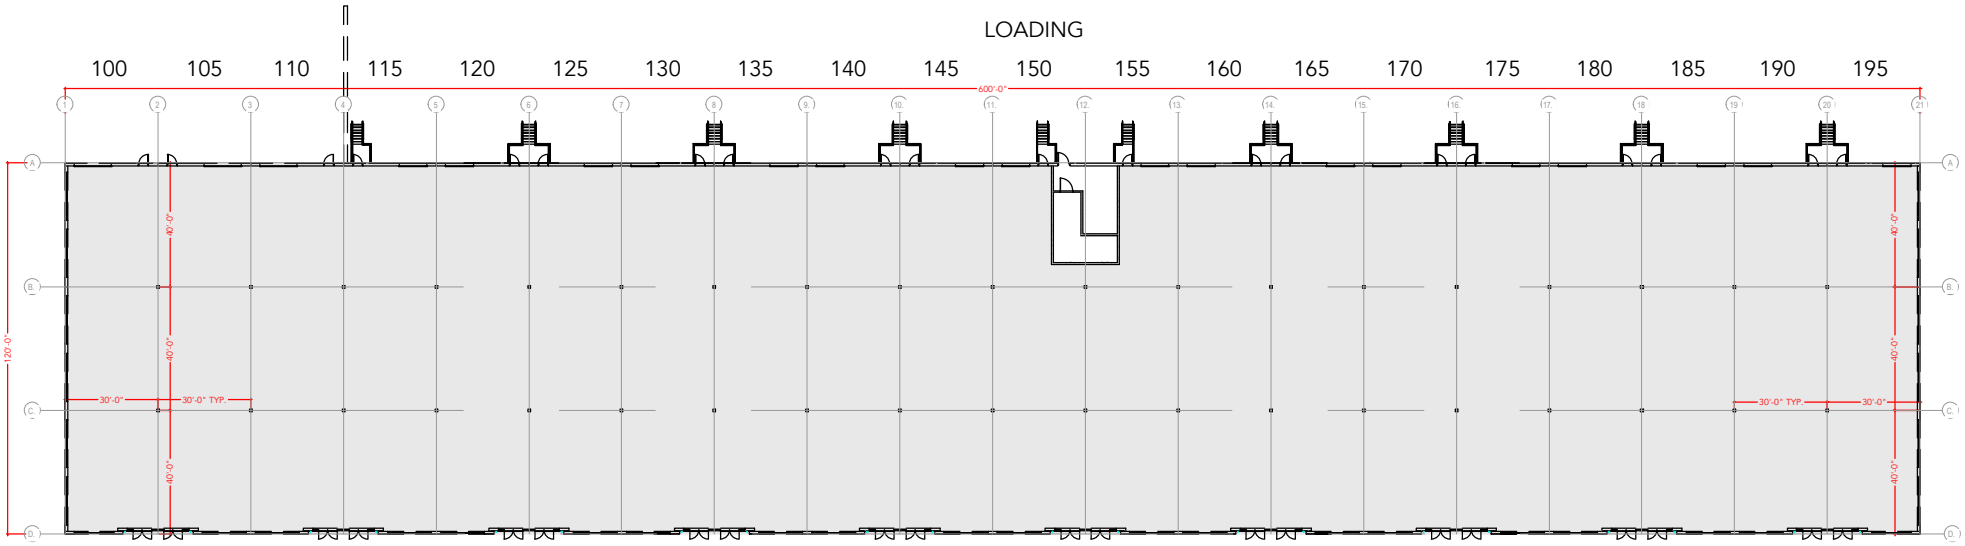

Floor Plan

PLAN NOT TO SCALE - THIS IS NOT A CONSTRUCTION DOCUMENT

DRAWING #: RDU-BUILDING12-100-195 ASBUILT DATE: NEEDS TO BE