RDU BUSINESS PARK WEST POD

2060 SEAGIRT AVE, MORRISVILLE, NC 27560

SUITES 100-155

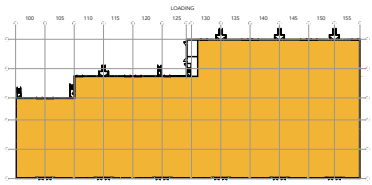

TOTAL SF AVAILABLE -75,250 RSF

OFFICE - 0,000 SF

WAREHOUSE - 75,250 RSF

Click to access **CADD file**

Key Plan

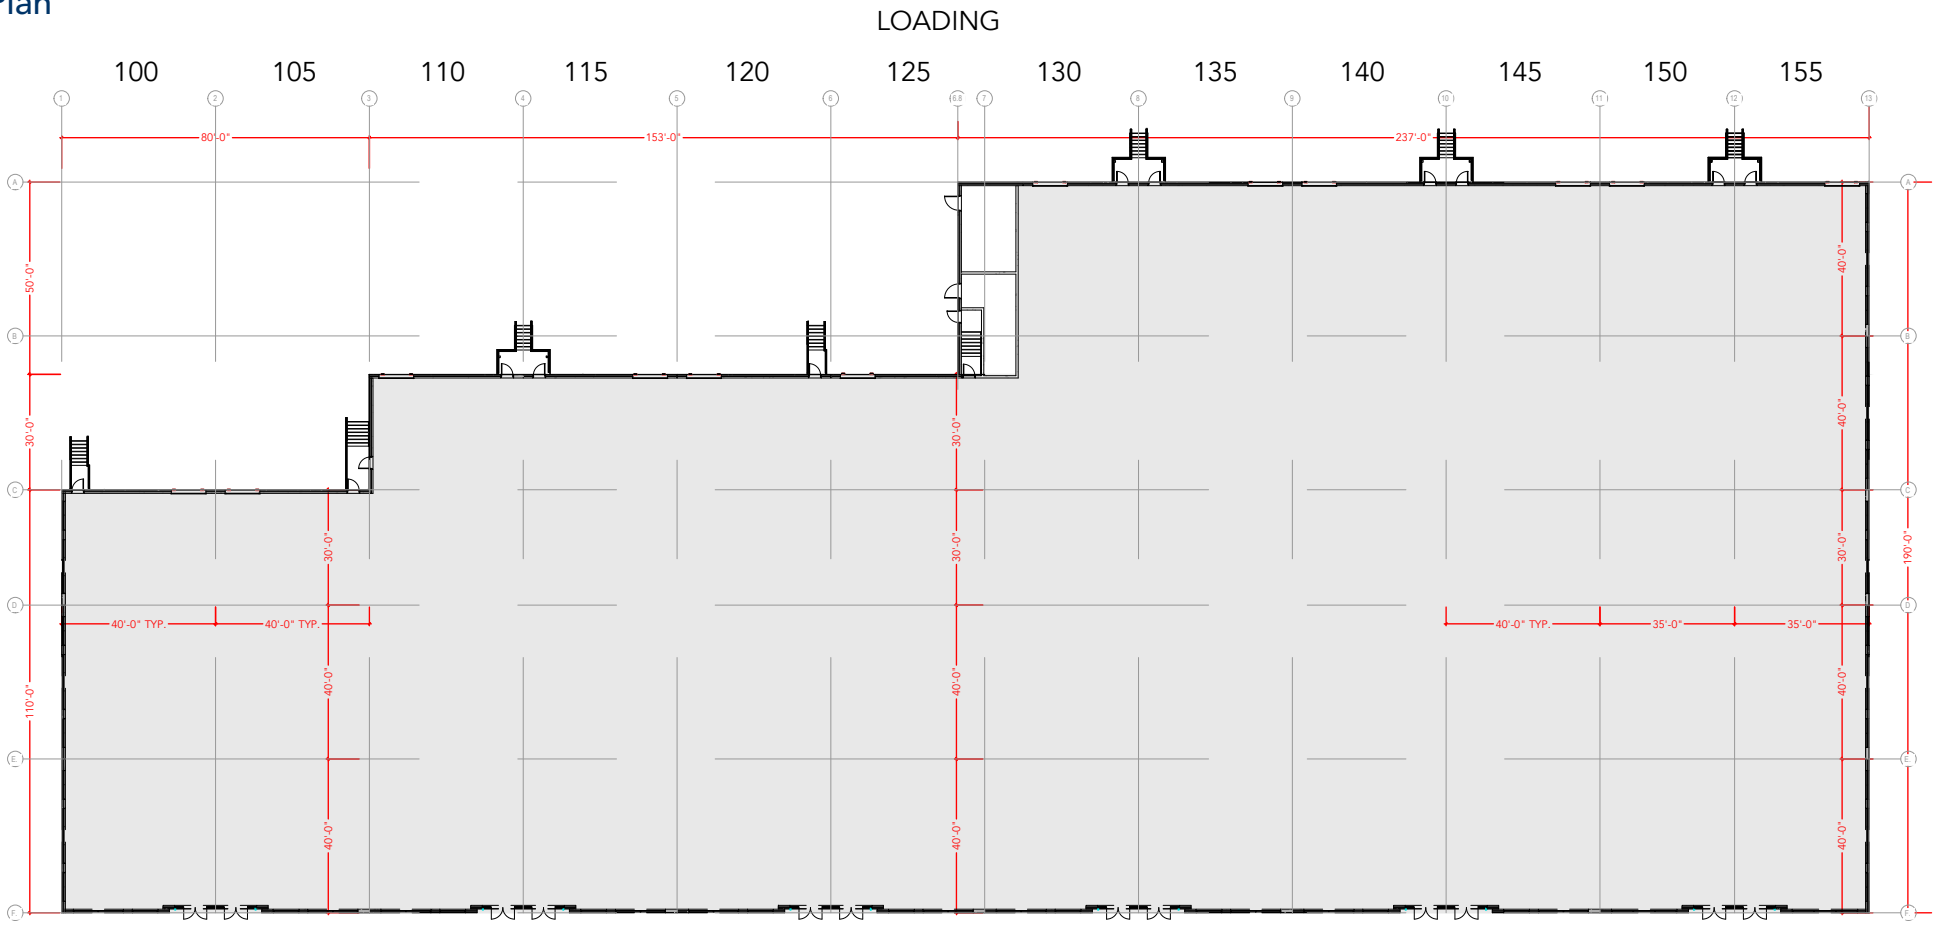

Floor Plan

PLAN NOT TO SCALE - THIS IS NOT A CONSTRUCTION DOCUMENT

DRAWING #: RDU-BUILDING13-100-155 ASBUILT DATE:NEEDS TO BE