SCHILLING SQUARE- BUILDING 3

235 SCHILLING CIRCLE, HUNT VALLEY, MD 21031

SUITE 109-113

merritt PROPERTIES

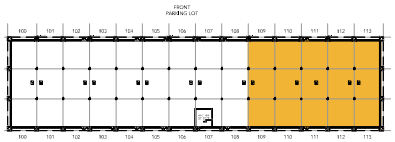

TOTAL SF AVAILABLE - 15,000 SF

OFFICE - 15,000 SF

WAREHOUSE - 0,000 SF

Key Plan

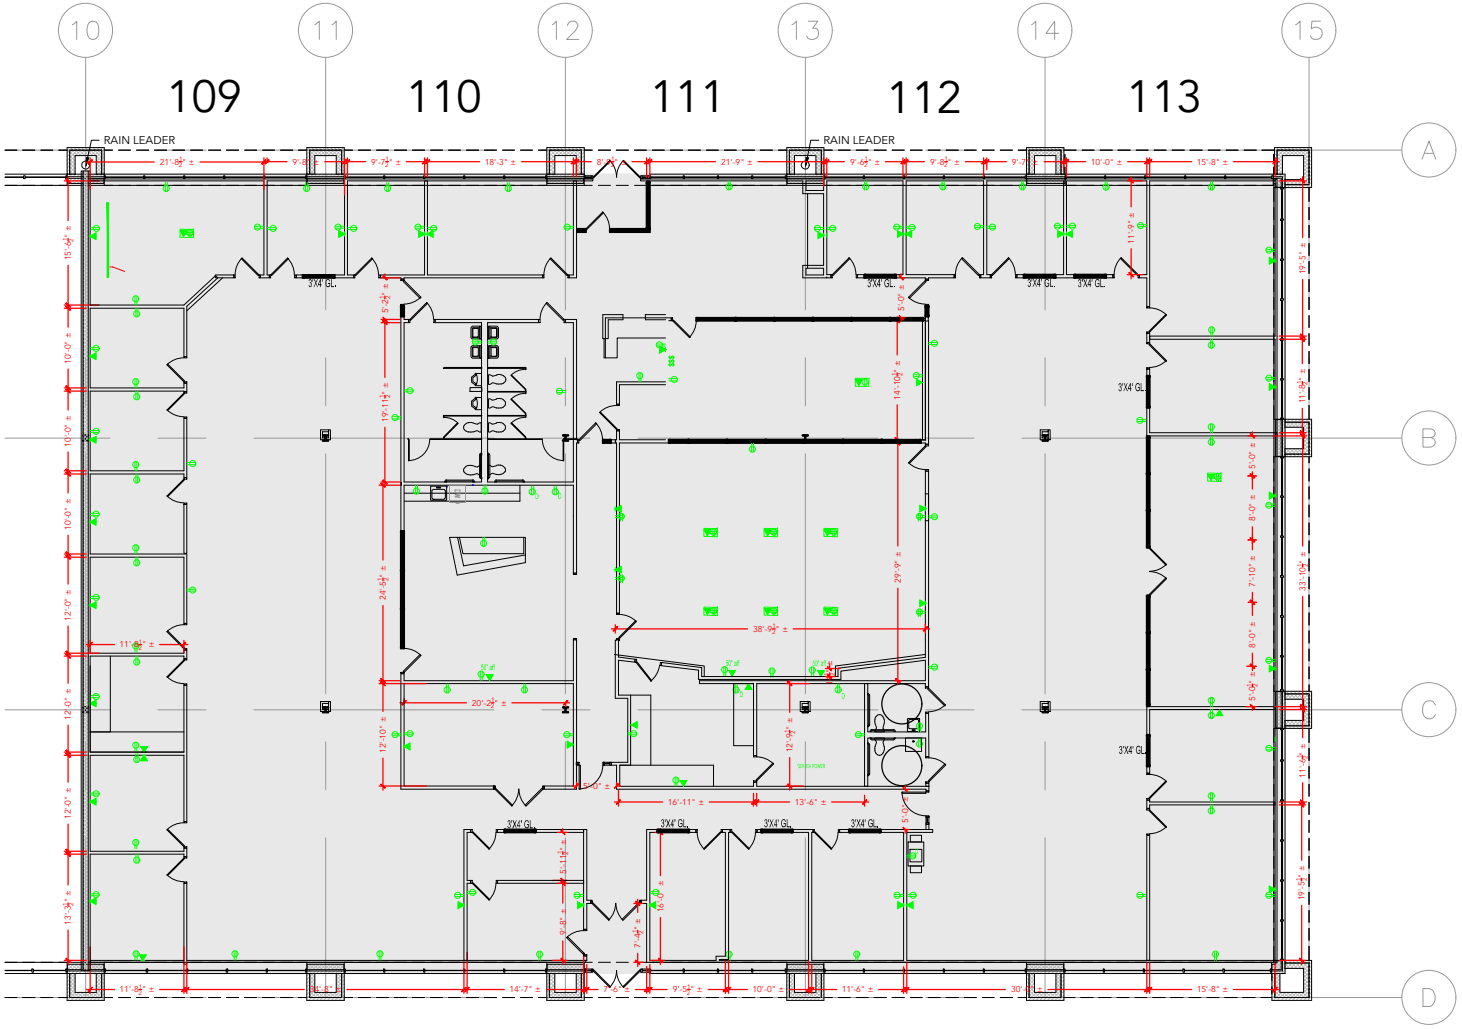

Floor Plan

PLAN NOT TO SCALE - THIS IS NOT A CONSTRUCTION DOCUMENT

DRAWING #: SC3-109-113

ASBUILT DATE: **NEEDS TO BE**