TIMONIUM ONE

1966 GREENSPRING DRIVE, TIMONIUM, MD 21093

SUITE 300-390

TOTAL SF AVAILABLE -28,962 RSF (9%)



Key Plan

Click to access **CADD file**

Click to view space photos

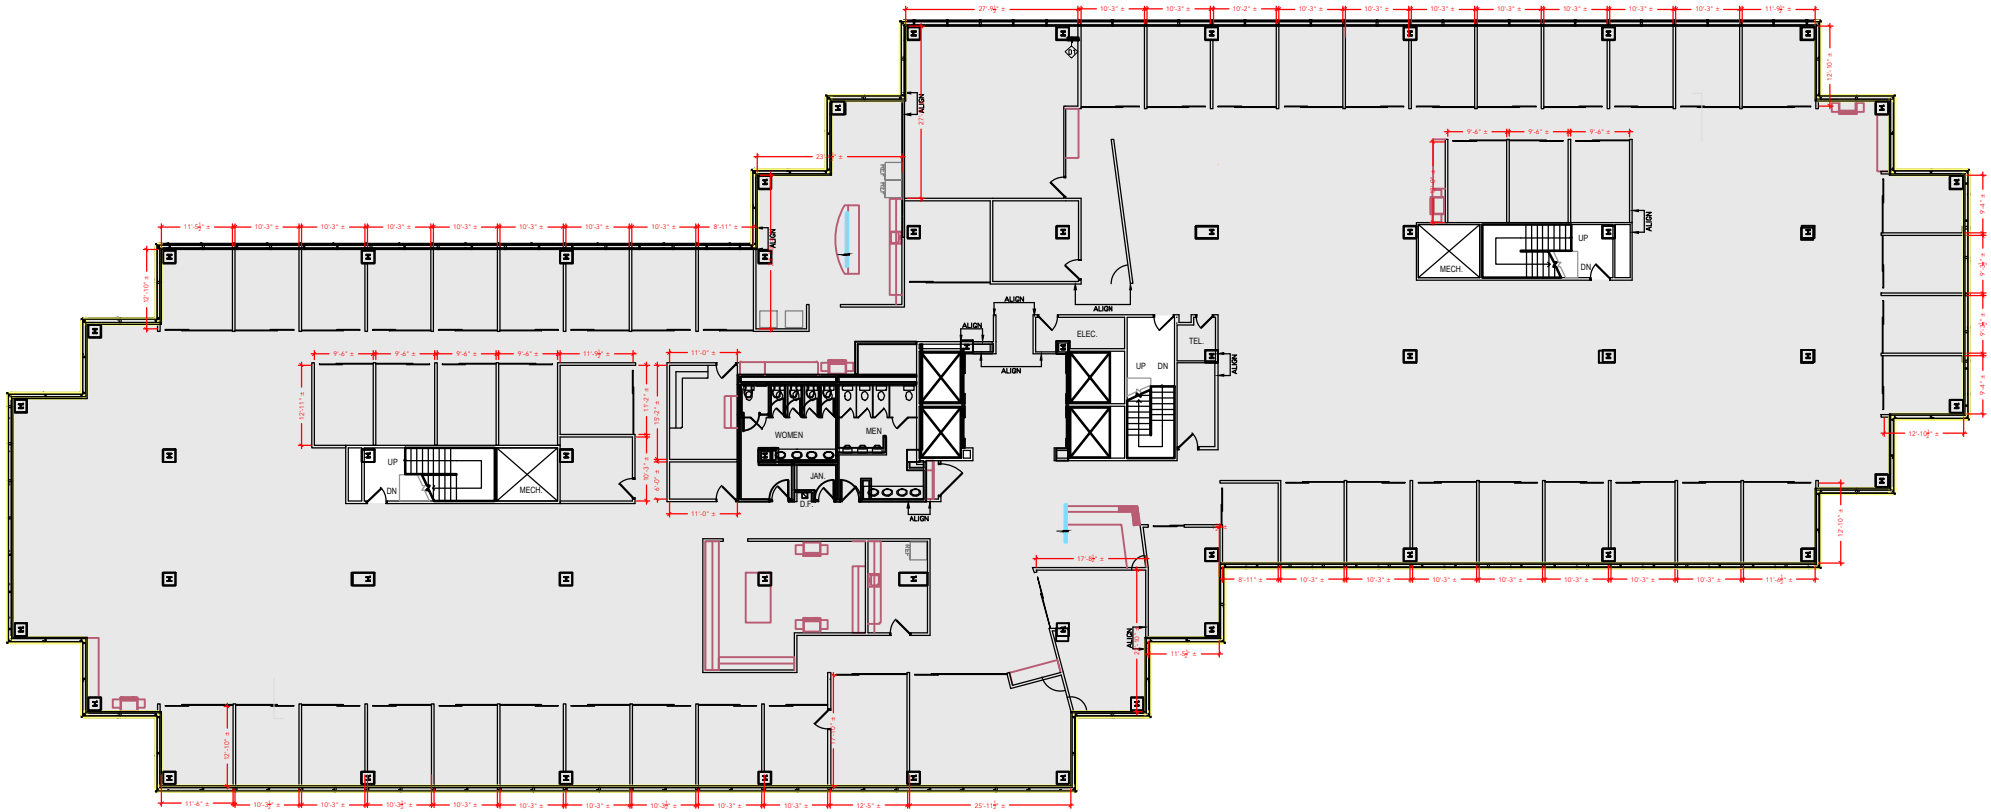

Floor Plan

PLAN NOT TO SCALE - THIS IS NOT A CONSTRUCTION DOCUMENT

DRAWING #: TD3-300-390 ASBUILT DATE: **NEEDS TO BE**