TIMONIUM TWO

1954 GREENSPRING DRIVE TIMONIUM, MD 21093
SUITE 350



TOTAL SF AVAILABLE -1,564 RSF(12%)

Click to access **CADD file**

Key Plan

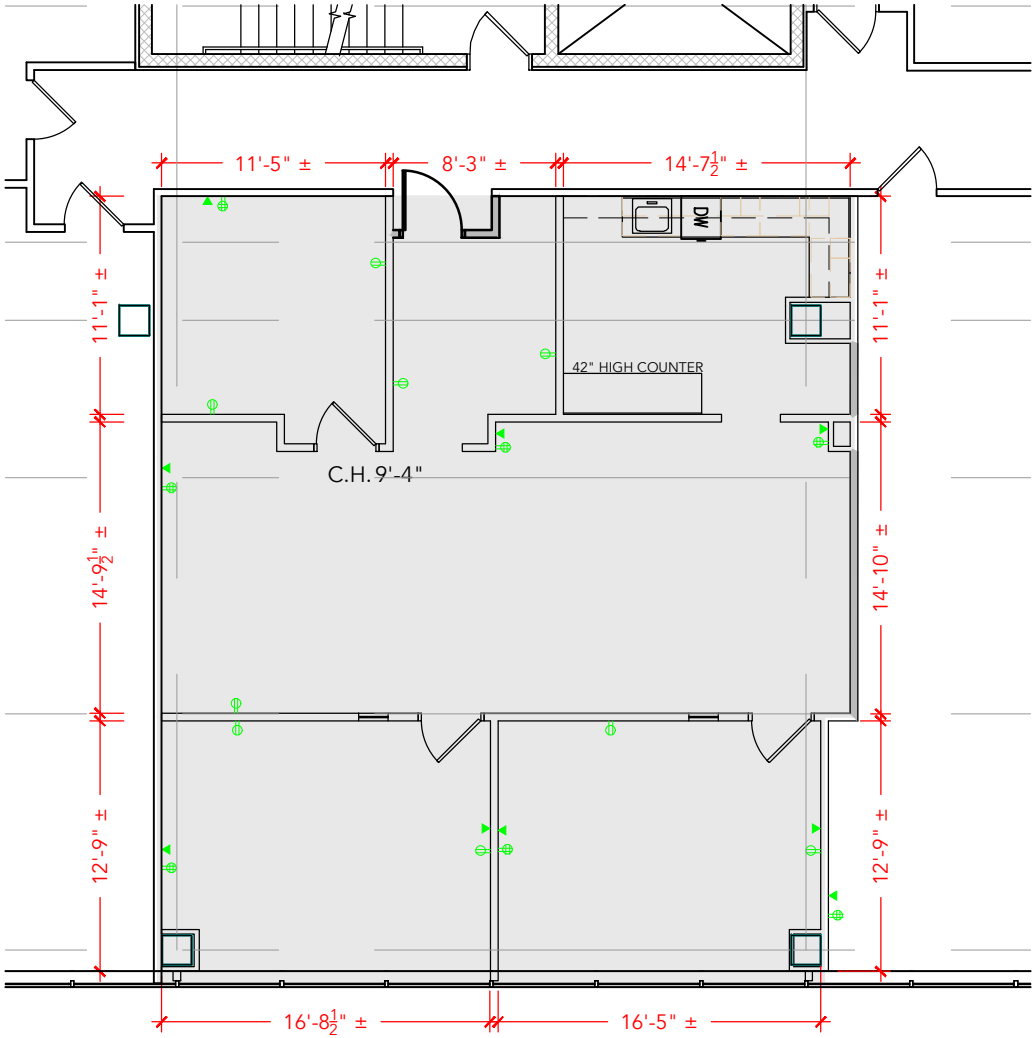

Floor Plan

PLAN NOT TO SCALE - THIS IS NOT A CONSTRUCTION DOCUMENT

DRAWING #: TD4-350 ASBUILT DATE:06.09.2026