merritt PROPERTIES

COLUMBIA CORPORATE PARK

8850 STANFORD BLVD. COLUMBIA, MD 21045

SUITES 4300-4400

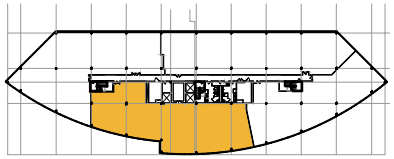

TOTAL SF AVAILABLE -6,481 RSF (16%)

Click to access **CADD file**

Key Plan

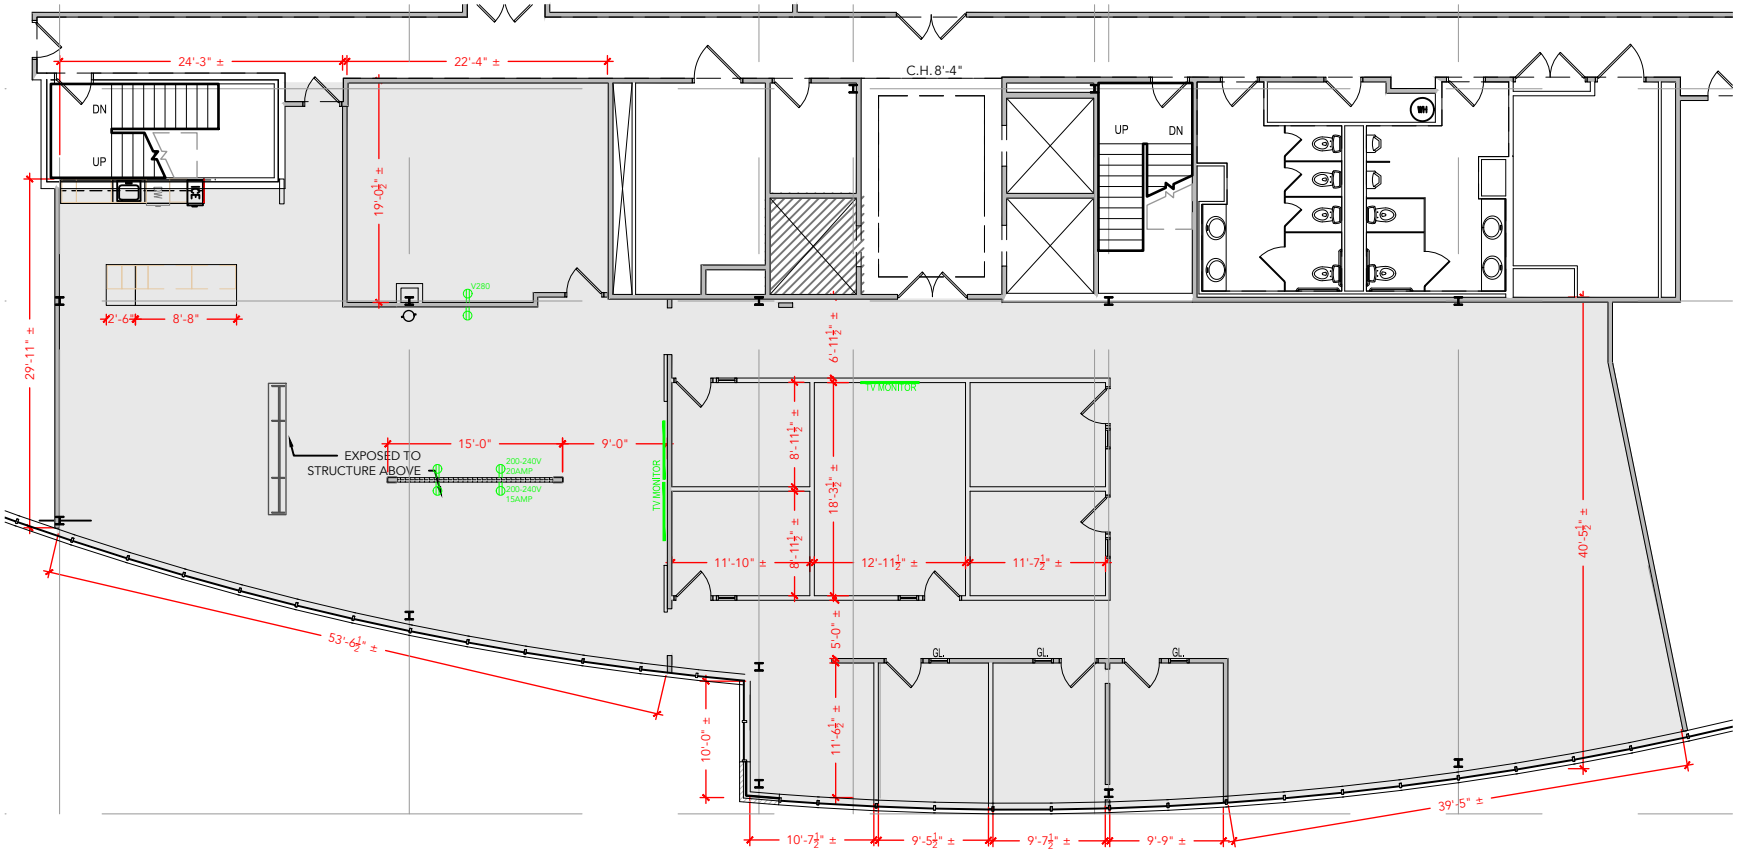

Floor Plan

PLAN NOT TO SCALE - THIS IS NOT A CONSTRUCTION DOCUMENT

DRAWING #: ZA1-4300-4400 ASBUILT DATE: **NEEDS TO BE**